

WATER WELL REPORT

Start Card No. **W102903**  
 Unique Well I.D. # **ACV860**  
 Water Right Permit No.

STATE OF WASHINGTON

(1) OWNER: Name **OVERMAN, LUELLA** Address **2235 A MARBLE VALLEY BSN ADDY, WA 99101-**

(2) LOCATION OF WELL: County **STEVENS** - **SW 1/4 SE 1/4 Sec 25 T 34 N., R 38E WM**  
 (2a) STREET ADDRESS OF WELL (or nearest address),

(3) PROPOSED USE: **DOMESTIC**

(10) WELL LOG

(4) TYPE OF WORK: Owner's Number of well  
 (If more than one) **1**  
**NEW WELL** Method: **ROTARY**

Formation: Describe by color, character, size of material and structure, and show thickness of aquifers and the kind and nature of the material in each stratum penetrated, with at least one entry for each change in formation

(5) DIMENSIONS: Diameter of well **6** inches  
 Drilled **58** ft. Depth of completed well **40** ft.

MATERIAL	FROM	TO
SAND GRAVEL	0	18
SAND	18	38
SAND GRAVEL	38	41
CLAY	41	58
	58	

(6) CONSTRUCTION DETAILS:  
 Casing installed: **6** " Dia. from **+1** ft. to **41** ft.  
**WELDED** " Dia. from ft. to ft.  
 " Dia. from ft. to ft.

Perforations: **NO**

Type of perforator used  
 SIZE of perforations in. by in.  
 perforations from ft. to ft.  
 perforations from ft. to ft.  
 perforations from ft. to ft.

Screens: **YES**

Manufacturer's Name **COOK**  
 Type **SLOTTED** Model No. **STAINLESS**  
 Diam. **5** slot size **10** from **33** ft. to **38** ft.  
 Diam. slot size from ft. to ft.

Gravel packed: **NO** Size of gravel  
 Gravel placed from ft. to ft.

Surface seal: **YES** To what depth? **19** ft.  
 Material used in seal **BENTONITE**  
 Did any strata contain unusable water? **NO**  
 Type of water? Depth of strata ft.  
 Method of sealing strata off **CASING**

(7) PUMP: Manufacturer's Name  
 Type **NONE** H.P.

(8) WATER LEVELS: Land-surface elevation  
 above mean sea level ... ft.  
 Static level **10** ft. below top of well Date **06/04/98**  
 Artesian Pressure lbs. per square inch Date  
 Artesian water controlled by **CAP**

Work started **06/03/98** Completed **06/04/98**

(9) WELL TESTS: Drawdown is amount water level is lowered below static level.

Was a pump test made? **NO** If yes, by whom?  
 Yield: gal./min with ft. drawdown after hrs.

Recovery data  
 Time Water Level Time Water Level Time Water Level

Date of test / /  
 Bailer test gal/min. ft. drawdown after hrs.  
 Air test **5** gal/min. w/ stem set at **37** ft. for **1** hrs.  
 Artesian flow g.p.m. Date  
 Temperature of water Was a chemical analysis made? **NO**

WELL CONSTRUCTOR CERTIFICATION:


I constructed and/or accept responsibility for construction of this well, and its compliance with all Washington well construction standards. Materials used and the information reported above are true to my best knowledge and belief.

NAME **FOGLE PUMP & SUPPLY, INC.**  
 (Person, firm, or corporation) (Type or print)

ADDRESS **316 W. 5TH COLVILLE, WA**

[SIGNED: *Ronald Humphreys* License No. **2258**

Contractor's  
 Registration No. **FOGLEPS095L4** Date **06/11/98**

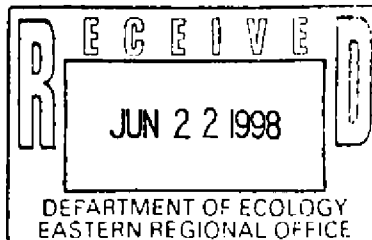

The Department of Ecology does NOT Warranty the Data and/or the Information on this Well Report.