

WATER WELL REPORT



Type of Work:
[] Construction
[] Decommission [] Original installation NOI No.

Proposed Use: [] Dewatering [] Irrigation [] Domestic [] Industrial [] Test Well [] Municipal [] Other

Construction Type: [] New well [] Alteration [] Deepening [] Other
Method: [] Driven [] Jetted [] Cable Tool [] Dug [] Air- [] Mud-Rotary

Dimensions: Diameter of boring 6 in., to 236 ft.
Depth of completed well 234 ft.

Construction Details table with columns for Casing, Liner, Diameter, From, To, Wall Thickness, Steel, PVC, Welded, Thread.

Perforations: [] Yes [] No
Type of perforator used
No. of perforations
Size of perforations in. by in.
Perforated from ft. to ft. below ground surface

Screens: [] Yes [] No
[] K-Packer [] Depth 226 ft.
Manufacturer's Name MACHINE ALLOY WORKS
Type STAINLESS
Model No.
Diameter 6" TEL in. Slot size 20 in. from 229 ft. to 234 ft.

Sand/Filter pack: [] Yes [] No
Size of pack material in.
Materials placed from ft. to ft.

Surface Seal: [] Yes [] No
To what depth? 18 ft.
Material used in seal BENTONITE
Did any strata contain unusable water? [] Yes [] No
Type of water?
Depth of strata
Method of sealing strata off

Pump: Manufacturer's Name
Type:
H.P.
Pump intake depth: ft.
Designed flow rate: gpm


Water Levels: Land-surface elevation above mean sea level ft.
Stick-up of top of well casing 2 ft. above ground surface
Static water level 129 ft. below top of well casing Date 10/5/22
Artesian pressure lbs. per square inch Date
Artesian water is controlled by (cap, valve, etc.)

Well Tests:
Was a pumping test performed? [] No [] Yes [] by whom?
Yield gpm with ft. drawdown after hrs.
Recovery data (time = zero when pump is turned off - water level measured from well top to water level)
Table with Time, Water Level, Time, Water Level, Time, Water Level.
Date of pumping test
Bailer test gpm with ft. drawdown after hrs.
Air test 20 gpm with stem set at 233 ft. for 1 hrs. Date 10/5/22
Artesian flow gpm
Temperature of water F Was a chemical analysis made? [] Yes [] No

Notice of Intent No. WE50668
Unique Ecology Well ID Tag No. BPC508
Site Well Name (if more than one well):
Water Right Permit/Certificate No.
Property Owner Name BILL AND JEANNE BYERS
Well Street Address 4692 MITCHELL RD
City NORTHPORT County STEVENS
Tax Parcel No. 5091900
Was a variance approved for this well? [] Yes [] No
If yes, what was the variance for?
Location (see instructions on page 2): [] WWM or [] EWM
SE 1/4-1/4 of the NE 1/4; Section 21 Township 40N Range 40E
Latitude (Example: 47.12345) 48.952561
Longitude (Example: -120.12345) -117.714534

Driller's Log/Construction or Decommission Procedure
Formation: Describe by color, character, size of material and structure, and the kind and nature of the material in each layer penetrated, with at least one entry for each change of information. Use additional sheets if necessary.

Table with 3 columns: Material, From, To. Rows include TOP SOIL, COBBLES, BOULDERS, GRAY SILTY CLAY, SAND AND GRAVEL w/WATER, FINE SAND.

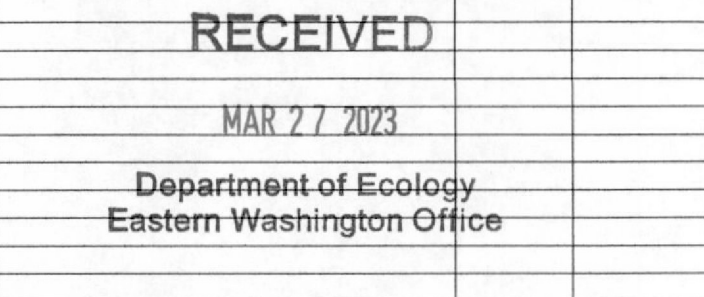

Start Date 9/27/22 Completed Date 10/5/22

WELL CONSTRUCTION CERTIFICATION: I constructed and/or accept responsibility for construction of this well, and its compliance with all Washington well construction standards. Materials used and the information reported above are true to my best knowledge and belief.

[] Driller [] Trainee [] PE - Print Name SAM BEARDSLEE
Signature
License No. 2905
IF TRAINEE: Sponsor's License No.
Sponsor's Signature

Drilling Company BEARDSLEE DRILLING
Address 409 E. ASTOR AVE
City, State, Zip COLVILLE, WA 99114
Contractor's
Registration No. BEARDDL818MA Date 10/22/22

The Department of Ecology does NOT warranty the Data and/or information on this well report.