


H. L. WOOD

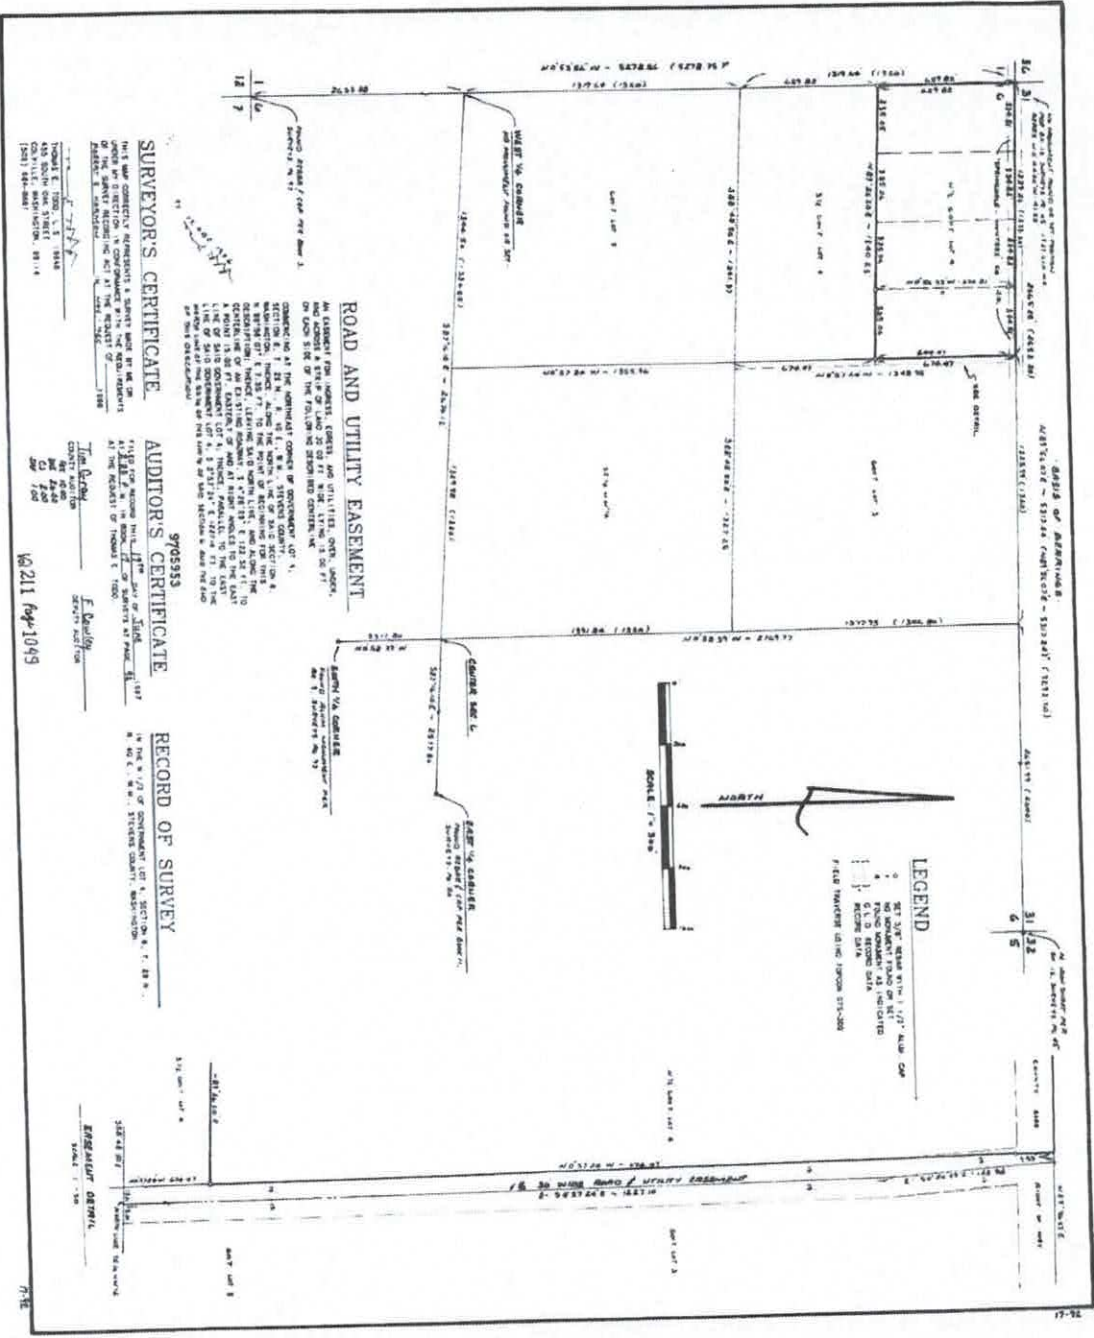

SURVEYOR'S CERTIFICATE

THIS MAP CORRECTLY REPRESENTS A SURVEY MADE BY ME OR UNDER MY DIRECT SUPERVISION IN ACCORDANCE WITH THE ACTS OF CONGRESS RELATIVE TO THE REGISTRATION OF LAND OFFICIALS IN THE DISTRICT OF COLUMBIA, AS AMENDED BY ACTS OF CONGRESS APPROVED MARCH 3, 1899 AND MAY 27, 1908.

AUDITOR'S CERTIFICATE
 9705953

THESE MAPS AND INSTRUMENTS HAVE BEEN EXAMINED BY ME AND I HAVE FOUND THEM TO BE TRUE AND CORRECTLY REPRESENT THE SURVEY AS SHOWN ON SAID INSTRUMENTS.

Witness my hand and the seal of the Auditor of the District of Columbia at Washington, D.C., on the 10th day of April, 1949.

RECORD OF SURVEY

IN THE S 1/4 OF QUARTER 167, SECTION 4, T. 49 N., R. 40 E., S.W., STEVEN COUNTY, MONTANA.

Filed for record on April 10, 1949.

16211 6pg-10-49

ENGINEER'S CERTIFICATE

7718