

Stevens County Parcel Map




DURPOS

Parcel No.	0307558
Acreage	0.56
Assessor Information	More info

[Zoom to](#)



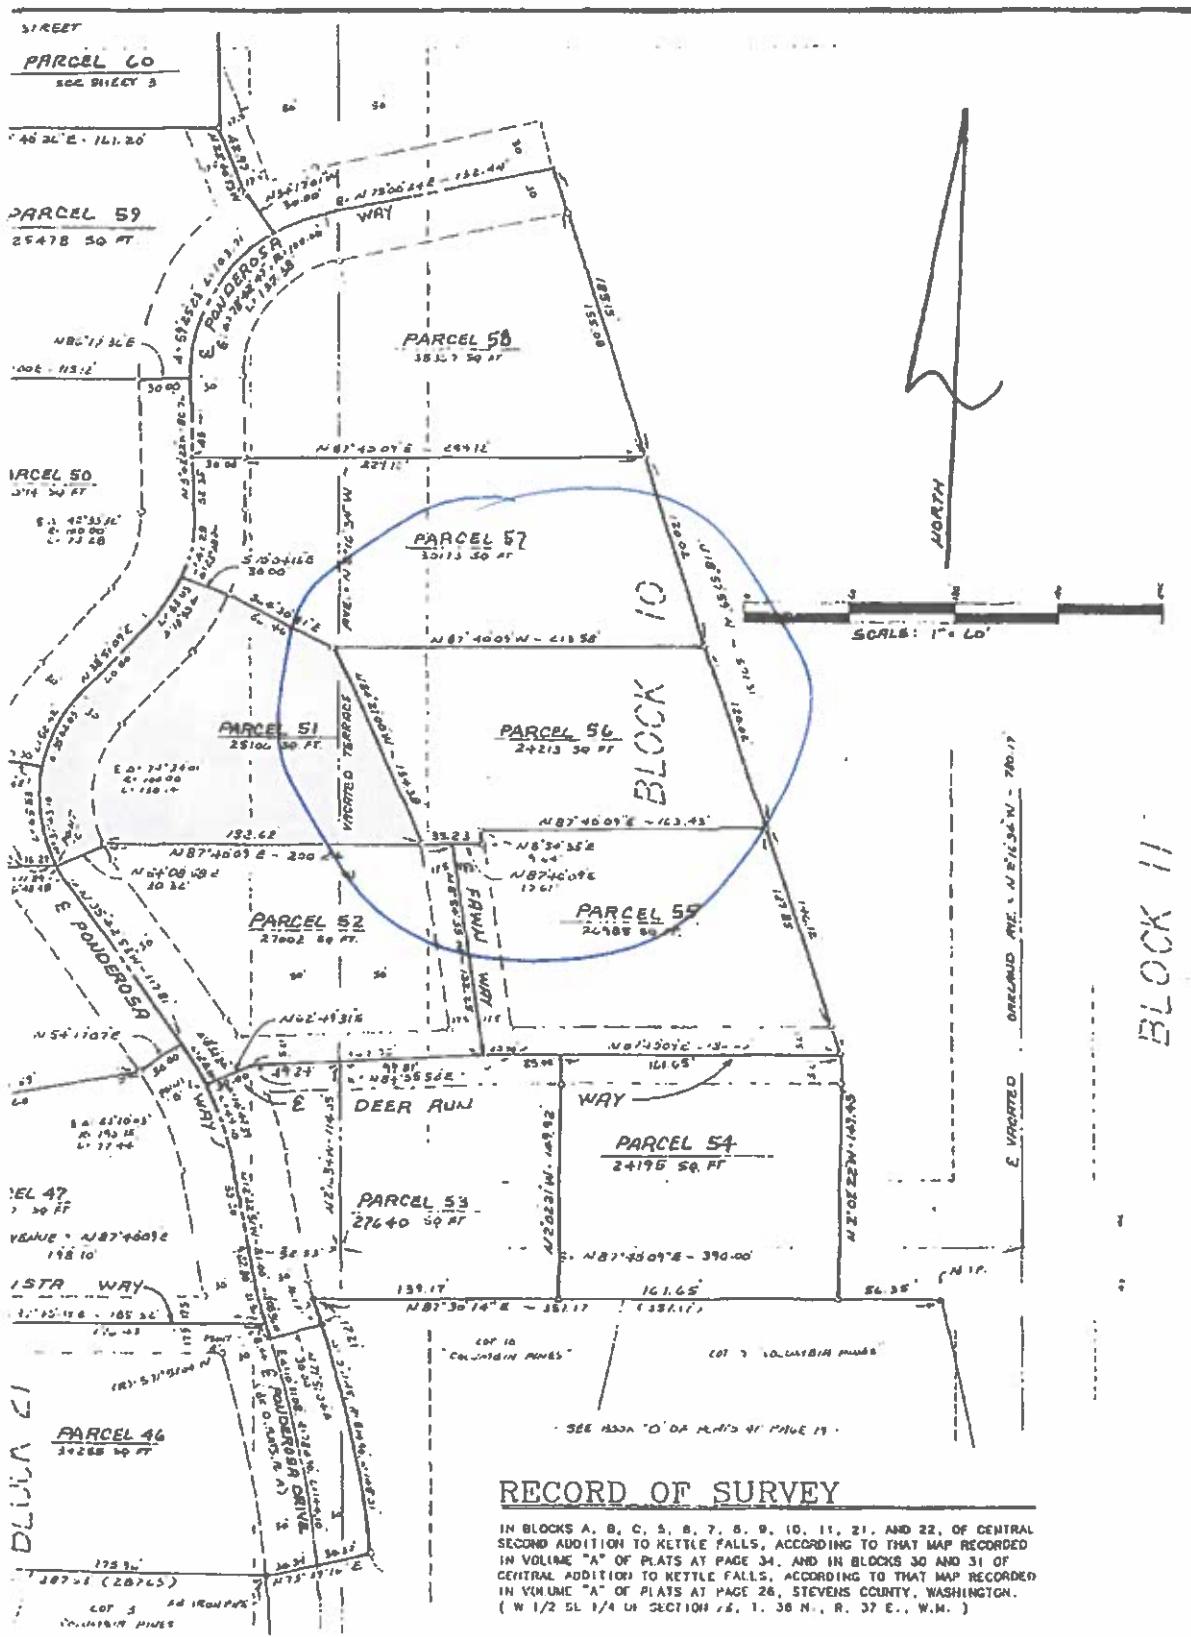

RECORD OF SURVEY

IN BLOCKS A, B, C, 5, 6, 7, 8, 9, 10, 11, 21, AND 22, OF CENTRAL SECOND ADDITION TO KETTLE FALLS, ACCORDING TO THAT MAP RECORDED IN VOLUME "A" OF PLATS AT PAGE 34, AND IN BLOCKS 30 AND 31 OF CENTRAL ADDITION TO KETTLE FALLS, ACCORDING TO THAT MAP RECORDED IN VOLUME "A" OF PLATS AT PAGE 26, STEVENS COUNTY, WASHINGTON. (W 1/2 5L 1/4 OF SECTION 12, T. 36 N., R. 37 E., W.M.)