

**WEST QUARTER**  
CALCULATED POSITION  
PER R1, NOT VISITED  
THIS SURVEY

**REFERENCES:**

- (R1). SURVEY RECORDED IN BOOK 23 OF SURVEYS, PAGES 51 THROUGH 54  
(R2). SURVEY RECORDED IN BOOK 22 OF SURVEYS, PAGES 72 THROUGH 76  
(R3). SURVEY RECORDED IN BOOK 20 OF SURVEYS, PAGE 218  
(R4). SURVEY RECORDED IN BOOK 6 OF SURVEYS, PAGES 35  
(R5). LAND CORNER RECORD FILED IN BOOK 14 OF LCR, PAGE 52  
(R6). LAND CORNER RECORD FILED IN BOOK 14 OF LCR, PAGE 53

**SURVEYOR'S NOTES**

- 1) THIS SURVEY WAS COMPLETED TO SET PROPERTY CORNERS AS SHOWN HEREON AT THE REQUEST OF STIMSON LUMBER COMPANY  
2) THE SUBDIVISION OF THE SOUTH HALF OF SECTION 35 WAS COMPUTED USING RECORD INFORMATION SHOWN ON THE SURVEYS RECORDED IN BOOK 23 OF SURVEYS, PAGES 51 THROUGH 54. MONUMENTS NOTED AS FOUND WERE WITHIN 0.10' OF THEIR CALCULATED POSITION, UNLESS NOTED OTHERWISE.  
3) NO ATTEMPT WAS MADE TO SHOW EXISTING EASEMENTS, RESTRICTIONS OR RESERVATIONS OF RECORD (IF ANY).  
4) THE METES AND BOUNDS LEGAL DESCRIPTION FOR LOT T-4 OF SP 94-78 HAD SEVERAL APPARENT SCRIBER ERRORS. THE FIRST, AND LEAST SIGNIFICANT WAS THE BEARING CALL IN THE SECOND COURSE OF N137°0'E. HOWEVER, THIS BEARING IS DUPLICATED ON THE FACE OF THE S. PLAT MAP. I THEREFORE HELD A BEARING OF N14°10'E FOR MY COMPUTATIONS. THE SECOND, A MOST SIGNIFICANT IS THE DISTANCE CALL OF 655' IN THE THIRD COURSE TO THE EAST RR R/W. THIS COMPUTES TO BE ONLY 478.93' IN THE FIELD. THIS COMPUTED DISTANCE DOES MATCH CLOSELY WITH THE SCALED DISTANCE OF 475' ON THE S. PLAT MAP. I FOUND NO EVIDENCE (POSSESSION) AT CONFLICT WITH THE SET CORNER

N89°02'39"W  
2665.18'

**REFERENCES:**

- SET TACK W/TAG #18091 ON SIDE 12"  
PONDEROSA PINE WITH FACE BLAZE, S59°E, 1.45'  
SET TACK W/TAG #18091 ON SIDE 8" PONDEROSA  
PINE WITH FACE BLAZE, S7°E, 8.6'

**REFERENCES:**

- SET TACK W/TAG #18091 ON SIDE 8"  
DOUGLAS FIR WITH FACE BLAZE, N53°W,  
28.33'  
SET TACK W/TAG #18091 ON SIDE 7"  
DOUGLAS FIR WITH FACE BLAZE, S62°W,  
42.18'

NE 1/4 SW 1/4

LOT T-4  
SP 94-78

**REFERENCES:**

- SET TACK W/TAG #18091 ON SIDE 9" LODGE POLE  
PINE WITH FACE BLAZE, N66°W, 9.68'  
SET TACK W/TAG #18091 ON SIDE 11" LODGE POLE  
PINE WITH FACE BLAZE, N9°E, 18.98'

SE 1/4 SW 1/4

**CENTER QUARTER**

CALCULATED POSITION  
PER R1, NOT VISITED  
THIS SURVEY

**EAST QUARTER**

FND 1979 DNR BRASS  
CAP PER R1 & R2'S  
PER R6

**AUDITOR'S CERTIFICATE:** MAY 2010  
FILED FOR RECORD THIS 22<sup>ND</sup> DAY OF  
MAY 2010 IN BOOK 30 OF SURVEYS AT PAGE 52  
AT THE REQUEST OF PAT MOORE & ASSOCIATES  
COUNTY AUDITOR: *Tim Gray* F. Clinton

N89°02'39"W

2628.03'



SCALE: 1"=200'

**LEGEND:**

- - FOUND 5/8" REBAR WITH 1 1/2" ALUM.  
CAP PER R2, UNLESS NOTED OTHERWISE  
● - SET 5/8" REBAR WITH 2" ALUMINUM CAP  
STAMPED "MOORE, LS 18091"  
▲ - CALCULATED POSITION, NOTHING SET

**REFERENCES:**

- SET TACK W/TAG #18091 ON SIDE 12" PONDEROSA  
PINE WITH FACE BLAZE, S14°W, 45.92'  
SET TACK W/TAG #18091 ON SIDE 28" PONDEROSA  
PINE WITH FACE BLAZE, S84°E, 18.08'

SW 1/4 SE 1/4

**S 1/4 CORNER**

CALCULATED POSITION  
PER R1, NOTHING FND,  
OR SET

**SECTION COR:**

FND 1979 DNR BRASS  
CAP PER R3 & R2'S  
PER R5

**SECTION COR:**

CALCULATED POSITION  
PER R1, NOTHING FND  
OR SET

**PROCEDURES AND EQUIPMENT:**

THIS SURVEY WAS PERFORMED USING A TOPCON  
"HYPER" RTK GPS SYSTEM AND TDS RANGER  
ELECTRONIC FIELD BOOK DATA COLLECTOR.  
PROCEDURES WERE USED THAT MEET OR EXCEED  
THE LINEAR AND ANGULAR REQUIREMENTS OF WAC  
332-130-090(1)(E) FOREST LAND AND CULTIVATED  
AREAS


**BASIS OF BEARINGS:**

THE BEARING SYSTEM USED FOR THE SURVEY  
RECORDED IN BOOK 23 OF SURVEYS, PAGES 51  
THROUGH 54 WAS USED AS THE BASIS OF BEARINGS  
FOR THIS MAP

**SURVEYOR'S CERTIFICATE:**

THIS MAP CORRECTLY REPRESENTS A SURVEY MADE BY ME OR  
UNDER MY DIRECTION IN CONFORMANCE WITH THE  
REQUIREMENTS OF THE SURVEY RECORDING ACT AT THE  
REQUEST OF STIMSON LUMBER COMPANY IN MAY, 2010

*Patrick J. Moore*  
PATRICK J. MOORE, PLS NO. 18091

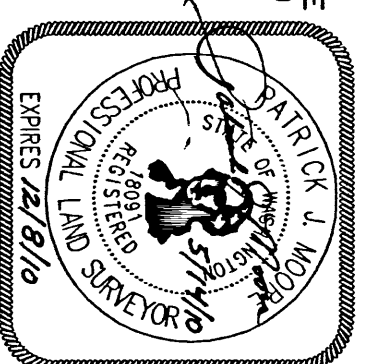

**RECORD OF SURVEY**

FOR  
STIMSON LUMBER COMPANY  
LOCATED IN THE  
SOUTH HALF OF  
SECTION 35, T31N, R40E, WM  
STEVENS COUNTY, WA  
MAY 2010

**PAT MOORE & ASSOCIATES, INC.**

7224 W. Johnsen Avenue  
Nine Mile Falls, WA 99026  
1-509-328-1224

PJM 10015