

WATER WELL REPORT

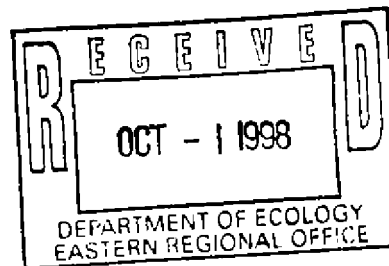
Start Card No. W102941

Unique Well I.D. # AEJ041

Water Right Permit No.

STATE OF WASHINGTON

(1) OWNER: Name CRANSTON, JERRY		Address D.M.R. 3071-D RICE, WA 99167-	
(2) LOCATION OF WELL: County STEVENS		- NW 1/4 NW 1/4 Sec 9 T 33 N., R 37E WM	
(2a) STREET ADDRESS OF WELL (or nearest address) DAISY BOAT LAUNCH,			
(3) PROPOSED USE: DOMESTIC		(10) WELL LOG	
(4) TYPE OF WORK:		Formation: Describe by color, character, size of material and structure, and show thickness of aquifers and the kind and nature of the material in each stratum penetrated, with at least one entry for each change in formation.	
Owner's Number of well (If more than one) 1			
NEW WELL Method: ROTARY			
(5) DIMENSIONS:		MATERIAL	
Diameter of well 6 inches			
Drilled 360 ft. Depth of completed well 360 ft.		CLAY FINE SAND	
		FROM 0 TO 29	
(6) CONSTRUCTION DETAILS:		LIMESTONE GRAY MEDIUM	
Casing installed: 6 " Dia. from +1 ft. to 29 ft.		29 40	
WELDED 4 " Dia. from 20 ft. to 360 ft.		LIMESTONE SOFT FRACTURED	
" Dia. from ft. to ft.		40 320	
		LIMESTONE SOFT FRACTURED	
		320 360	
		WATER BEARING	
		360	
Perforations: YES			
Type of perforator used SKILL SAW			
SIZE of perforations 1/4 in. by 6 in.			
14 perforations from 260 ft. to 280 ft.			
14 perforations from 300 ft. to 320 ft.			
14 perforations from 340 ft. to 360 ft.			
Screens: NO			
Manufacturer's Name			
Type Model No.			
Diam. slot size from ft. to ft.			
Diam. slot size from ft. to ft.			
Gravel packed: NO			
Gravel placed from ft. to ft.			
Surface seal: YES			
To what depth? 19 ft.			
Material used in seal BENTONITE			
Did any strata contain unusable water? NO			
Type of water? Depth of strata ft.			
Method of sealing strata off CASING			
(7) PUMP: Manufacturer's Name			
Type NONE H.P.			
(8) WATER LEVELS:			
Land-surface elevation			
above mean sea level ... ft.			
Static level 60 ft. below top of well Date 08/18/98			
Artesian Pressure lbs. per square inch Date			
Artesian water controlled by CAP			
(9) WELL TESTS: Drawdown is amount water level is lowered below static level.		WELL CONSTRUCTOR CERTIFICATION:	
Was a pump test made? NO If yes, by whom?		I constructed and/or accept responsibility for construction of this well, and its compliance with all Washington well construction standards. Materials used and the information reported above are true to my best knowledge and belief.	
Yield: gal./min with ft. drawdown after hrs.			
Recovery data			
Time Water Level Time Water Level Time Water Level			
Date of test / /		NAME FOGLE PUMP & SUPPLY, INC.	
Bailer test gal/min. ft. drawdown after hrs.		(Person, firm, or corporation) (Type or print)	
Air test 25 gal/min. w/ stem set at 359 ft. for 1 hrs.		ADDRESS 316 W. 5TH COLVILLE, WA	
Artesian flow g.p.m. Date		[SIGNED] <i>Ronald Hurn</i> License No. 2258	
Temperature of water Was a chemical analysis made? NO		Contractor's	
		Registration No. FOGLEPS095L4 Date 08/19/98	

Work started **08/14/98**Completed **08/18/98**