

Auditor File #: 2006 0000079

Recorded at the request of:

TODD, THOMAS E.

on 01/04/2006 at 11:10

Total of 1 page(s) Paid: \$ 98.00

STEVENS COUNTY, WASHINGTON

TIM GRAY, AUDITOR

SURVEY KKUHLE

OWNERS NEIL CHRISTMAN & IVA CHRISTMAN

TO SURVEY
FILED BY THOMAS E. TODD

SURVEYOR THOMAS E. TODD

SURVEY BOOK 26 **PAGE** 1

FEE\$ 25.70 **DNR\$** 46.00

CS \$ 5.00 **SAF\$** 2.00

LOW INCOME HOUSING \$ 9.50 **HOMELESS** 9.80

LEGAL DESCRIPTION: SECTION 7 **TWP** 35 **RGE** 40

LEGAL DESCRIPTION: SECTION **TWP** **RGE**

LEGAL DESCRIPTION: SECTION **TWP** **RGE**

LEGAL DESCRIPTION: SECTION **TWP** **RGE**

ADDITIONAL INFORMATION: PORTION NW1/4 NE/14 & SE1/4 NE1/4

SURVEYORS CERTIFICATE

THIS MAP CORRECTLY REPRESENTS A SURVEY MADE BY ME OR UNDER MY DIRECTION IN CONFORMANCE WITH THE REQUIREMENTS OF THE SURVEY RECORDING ACT AT THE REQUEST OF DELTA CRYSTALLINE & THE CRYSTALLINE IN RAVENS 2005.

THOMAS E. TODD, L.S. 19848
THOMAS E. TODD LAND SURVEYOR, LLC
455 SOUTH OAK STREET
COLVILLE, WA, 99114
(509) 684-8651



AUDITOR'S CERTIFICATE

2006 0000079
FILED FOR RECORD THIS 4TH DAY OF JANUARY 2006
AT 11:00 A.M. IN BOOK 26 OF SURVEYS AT PAGE 1
AT THE REQUEST OF THOMAS E. TODD.

Tim Gray
COUNTY AUDITOR
F. Clinton
DEPUTY AUDITOR
898.00

RECORD OF SURVEY

IN THE NW 1/4 OF THE NE 1/4 AND IN THE SE 1/4 OF THE NE 1/4, ALL IN SECTION 7, T. 38 N., R. 40 E., W. M., STEVENS COUNTY, WASHINGTON.

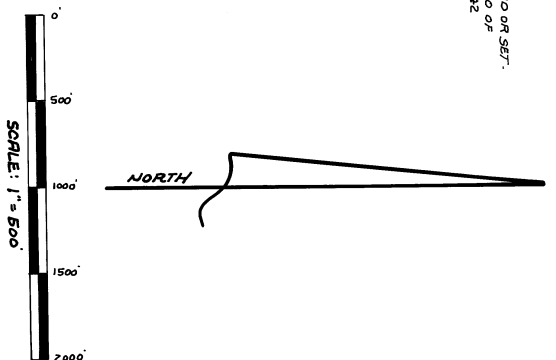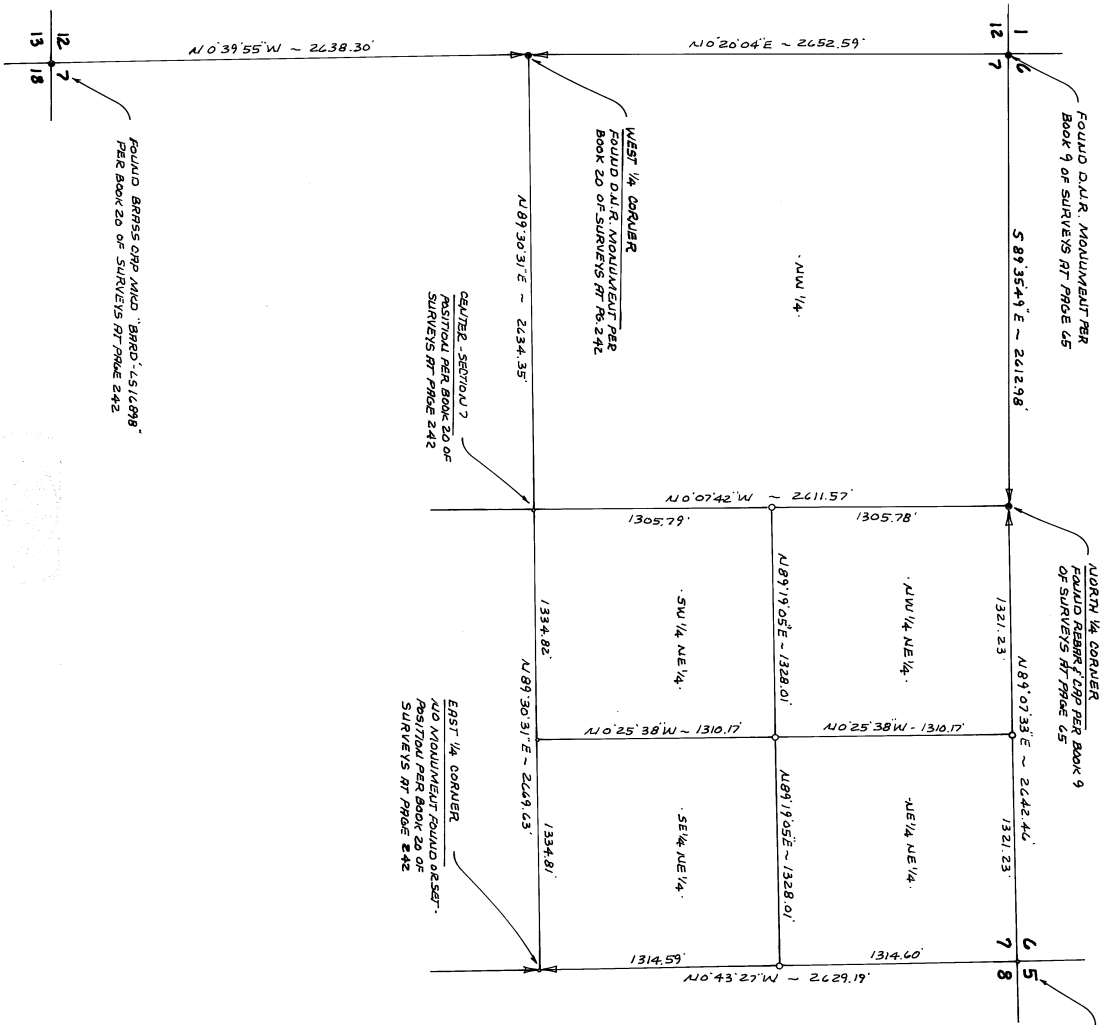

LEGEND

- SET 5/8" REBAR WITH 1 1/2" ALUM. CAP.
- NO MONUMENT FOUND OR SET
- SET HUB AND LATH ONLINE
- FOUND MONUMENT AS INDICATED
- (.....) RECORD DATA

FIELD TRAVERSE USING TOPCON GTS-235W
BASIS OF BEARINGS AND SURVEY DATA BASED ON THAT
MAP RECORDED IN BOOK 20 OF SURVEYS AT 242