

# WATER WELL REPORT

184650

State of Washington Date Printed: 07-Nov-2005  
Construction / Decommission: Original  
Construction Construction Notice

Log No.  
47905

**CURRENT**

Notice of Intent No.: W237566  
Unique Ecology Well I.D. No APN318  
Water Right Permit Number:  
OWNER: EDWARDS, JEFFREY

OWNER ADD 3365 ROCK CUT RD  
KETTLE FALLS, WA 99141

Well Add 623 GREENWOOD LOOP RD


City: Kettle Falls, WA 99141 County: Stevens  
Location: SE 1/4 SE 1/4 Sec 34 T 36 R 38E EW  
Lat/Long: Lat Deg Lat Min/Sec  
(s, t, r still) Long Deg Long Min/Sec  
REQUIRED)  
Tax Parcel No.: 1946300

**CONSTRUCTION OR DECOMMISSION PROCEDURE**

Formation: Describe by color, character, size of material and structure. Show thickness of aquifers and the kind and nature of the material in each stratum penetrated. Show at least one entry for each change in formation.

Material	From	To
CLAY DENSE GRAVEL BROWN	0	24
BLACK CLAY GRAVEL HARD	24	109
CEMENTED SAND HARD	109	121
BROWN CLAY MOIST	121	144
BROWN GRANITE MED	144	180
GRAY GRANITE HARD	180	274
BROWN GRANTIE WWATER	274	278
GRAY GRANITE HARD	278	300

Notes:

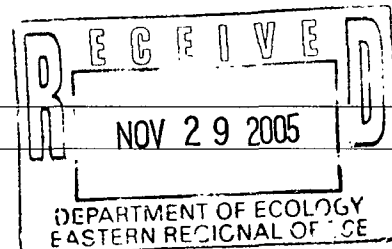

Work starte 10/03/2005

Complete 10/05/2005

**WELL CONSTRUCTION CERTIFICATION:**

I constructed and/or accept responsibility for construction of this well and its compliance with all Washington well construction standards. Materials used and the information reported are true to my best knowledge and belief.

☐ Driller ☐ Engineer ☒ Trainee

Name: ANDREW BAKER License No.: 2751T

Signature: *Andrew Baker*

If trainee, Licensed driller is: RONALD HURN License No.: 2258

Licensed Driller Signature: *Ronald Hurn*

**Drilling Company:**

NAME: FOGLE PUMP & SUPPLY, INC. Shop: COLVILLE  
ADDRESS: 316 W. 5TH  
Colville, WA 99114  
Phone: 509-684-2569 Toll Free: 800-533-6518  
E-Mail: jrs@foglepump.com  
FAX: 509-684-3032 WEB Site: www.foglepump.com

Contractor's  
Registration No.: FOGLEPS095L4 Date Log Created: 11/05/200

\*PROPOSED USE: DOMESTIC

TYPE OF WORK: Owners's Well Number: (If more than one well) 1  
NEW WELL Method: ROTARY

DIMENSIONS Diameter of well: 6 inches  
Drilled 300 ft. Depth of completed well 300 ft.

CONSTRUCTION DETAILS: Casing installed WELDED  
Liner installed: PVC  
4 " Dia from 20 ft. to 300 ft. 6 " Dia from +2 ft. to 164 ft.  
" Dia from ft. to ft.  
" Dia from ft. to ft.

Perforations: Yes Used In: Liner

Type of perforator used SKILL SAW

SIZE of perforations 6 in. b 1/8 in.  
80 Perforation from 200 ft. to 300 ft.  
Perforation from ft. to ft.  
Perforation from ft. to ft.

Screens: No K-Pac Location

Manufacture's Name

Type: Model No  
Diam. slot size from ft. to ft.  
Diam. slot size from ft. to ft.

Gravel/Filter packed: No Size of Gravel

Material placed fro ft. to ft.

Surface seal: Yes To what depth 164 ft.

Seal method: Material used in seal BENTONITE

Did any strata contain unusable water No  
Type of water Depth of strata

Method of sealing strata off

PUMP: Manufacture's name

Type: H.P. 0

WATER LEVELS Land-surface elevation above mean sea level: 0 ft.

Static level 120 ft. below top of well Date 10/05/2005

Artesian Pressure lbs per square inch Date

Artesian water controlled by

WELL TESTS: Drawdown is amount water level is lowered below static level.

Was a pump test made No If yes, by whom

Yield gal/min with ft drawdown after  
Yield gal/min with ft drawdown after  
Yield gal/min with ft drawdown after

Recovery data (time taken as zero when pump turned off)(water level measured from well top to water level)

Time:	Water Level	Time:	Water Level	Time:	Water Level

Date of test:

Bailer test gal/min ft drawdown after hrs.

Air test 6 gal/min w/ stem set at 299 ft. for 1 hours

Artesian flow gpm Date

Temperature of water Was a chemical analysis made No