

**NORTHEAST TRI COUNTY HEALTH DISTRICT
DIVISION OF ENVIRONMENTAL HEALTH**

ON-SITE SEWAGE SYSTEM PERMIT # PT0018763

**Lisa Vaughn and Jennifer Thornburg is hereby authorized to utilize a sewage disposal system at
Tax #1 (SP 51-79-A)**

Section: 21 Township: 38 Range: 37 Parcel #: 1732600

in accordance with the plans and specifications approved by the District Health Officer on file in this office.

Prior to any major repairs, replacements or alterations to the system a permit shall be obtained from the NorthEast Tri County Health District (Division of Environmental Health).

This permit is issued and may be revoked by the NorthEast Tri County Health District Health Officer by authority of WAC 246-272, and Northeast Tri County Health District Regulations established by the Board of Health pursuant to RCW 70.05.

Additional permits from other jurisdictions or agencies may be necessary for this project. It is the responsibility of the applicant to acquire said permit(s), and comply with all applicable rules, regulations and/or ordinances.



Date Issued: 11/26/2018

District Health Officer

PERMIT INSTRUCTIONS

STRUCTURE TYPE:

DFLF/BED DIMENSIONS:

NUMBER OF BEDROOMS:

TRENCH DEPTH (inches):

DESIGN FLOW (gal/day):

TENCH WIDTH (inches):

TYPE OF SYSTEM:

APPURTANENCES:

SYSTEM DESIGN: Pump/Gravity/Chambers

PUMP CHAMBER (y/n): Y

SEPTIC TANK CAPACITY(gal): 1500

PUMP CHAMBER GALLONS: 1000

REASON SYSTEM DESIGN:

SPECIAL PERMIT INSTRUCTIONS: NEW PUMP CHAMBER, PUMP AND CONTROL PANEL FOR EXISTING PERMIT #5001643

FINAL INSPECTION DATE: 11/28/18

Initials: BH

Stevens County Office

240 E Dominion

Colville,

WA

99114

(509) 684-2262

Pend Oreille County Office

605 Hwy 20

Newport,

WA

99156

(509) 447-3131

Ferry County Office

P.O. Box 584

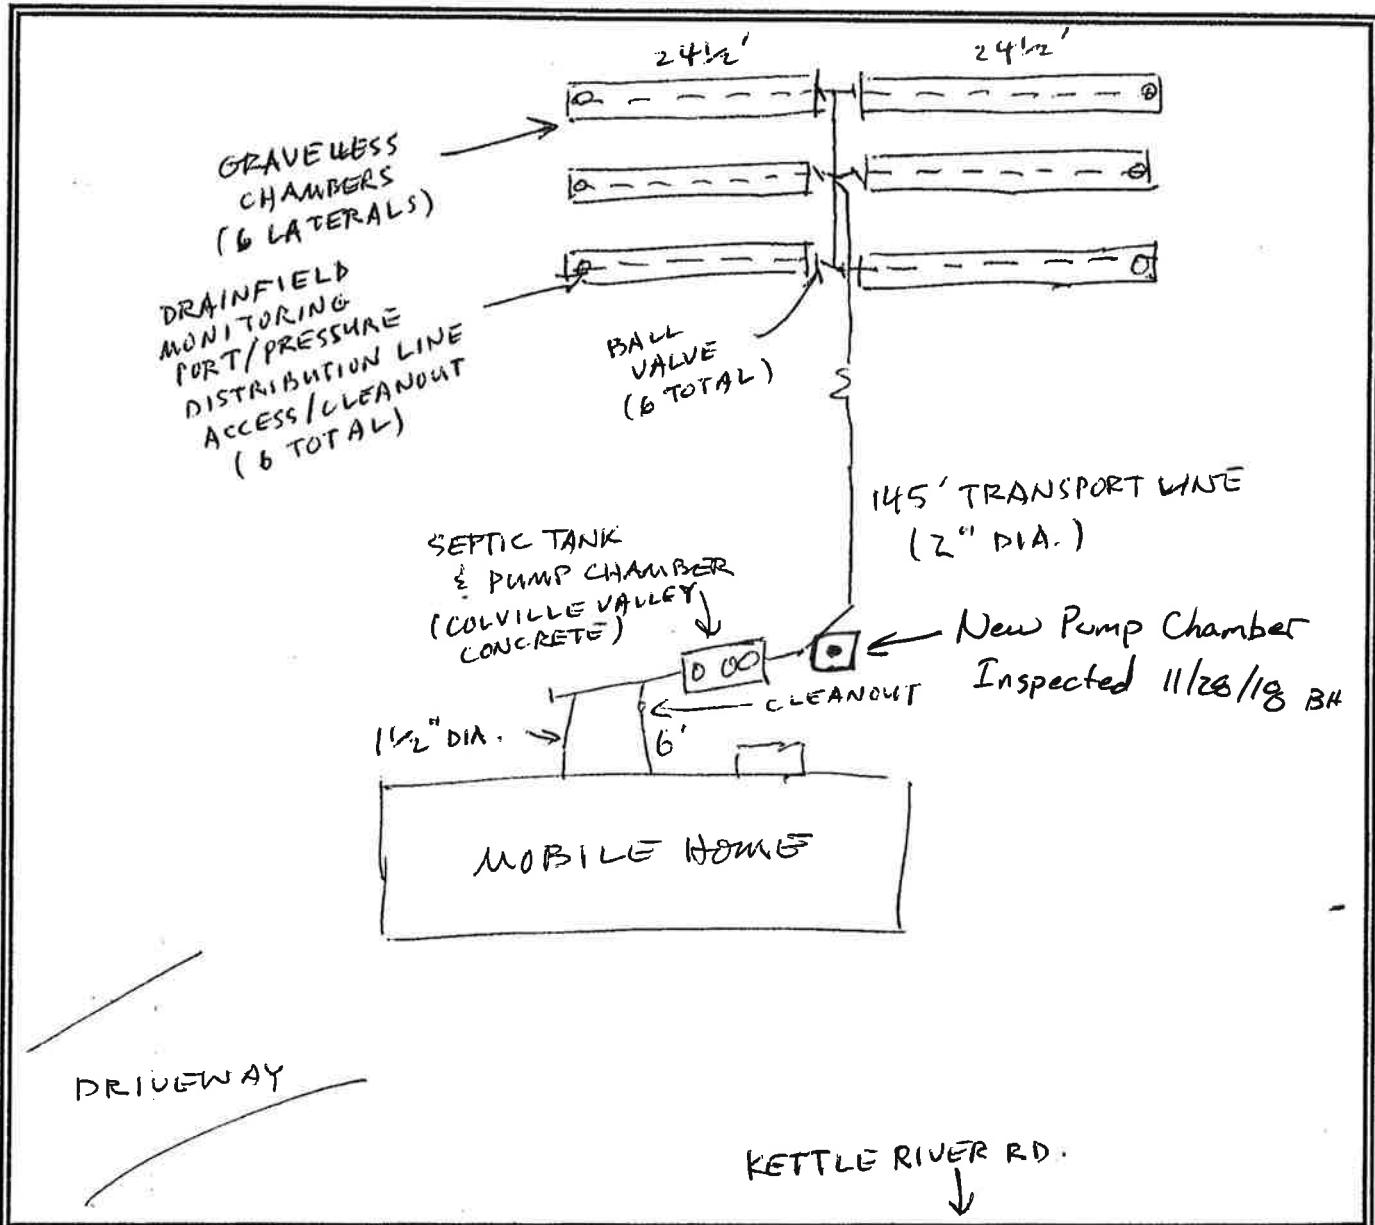
Republic,

WA

99166

(509) 775-3111

SIC 2850

NORTHEAST TRI COUNTY HEALTH DISTRICT
AS-BUILT DRAWING - PERMIT # 5001643INSPECTION DATE 6/23/03 INSPECTED BY MA APPROVED: YES NO

Installer Name VANCE DURPOS & RANDY ANDERSON
 Septic Tank Size 1000 GAL.
 Drainfield Length 150'
 Drainfield Depth 26"

Pump Chamber Size 500 GAL.
 Doses/Day 4 Gallons/Dose 91*
 Squirt Height 5' Drawdown 7 3/4"
 Pump Run Time 2 min. 10 sec. (4 hrs. OFF)
 * includes 31 gal. drainback from transport.

(Revised 7/2003)

New Run Time 1:56 11/28/18 BH