




WATER PRESSURE  
PSI

# NORTHWEST HYDRO-FRACTURING

Dept. of Ecology # \_\_\_\_\_

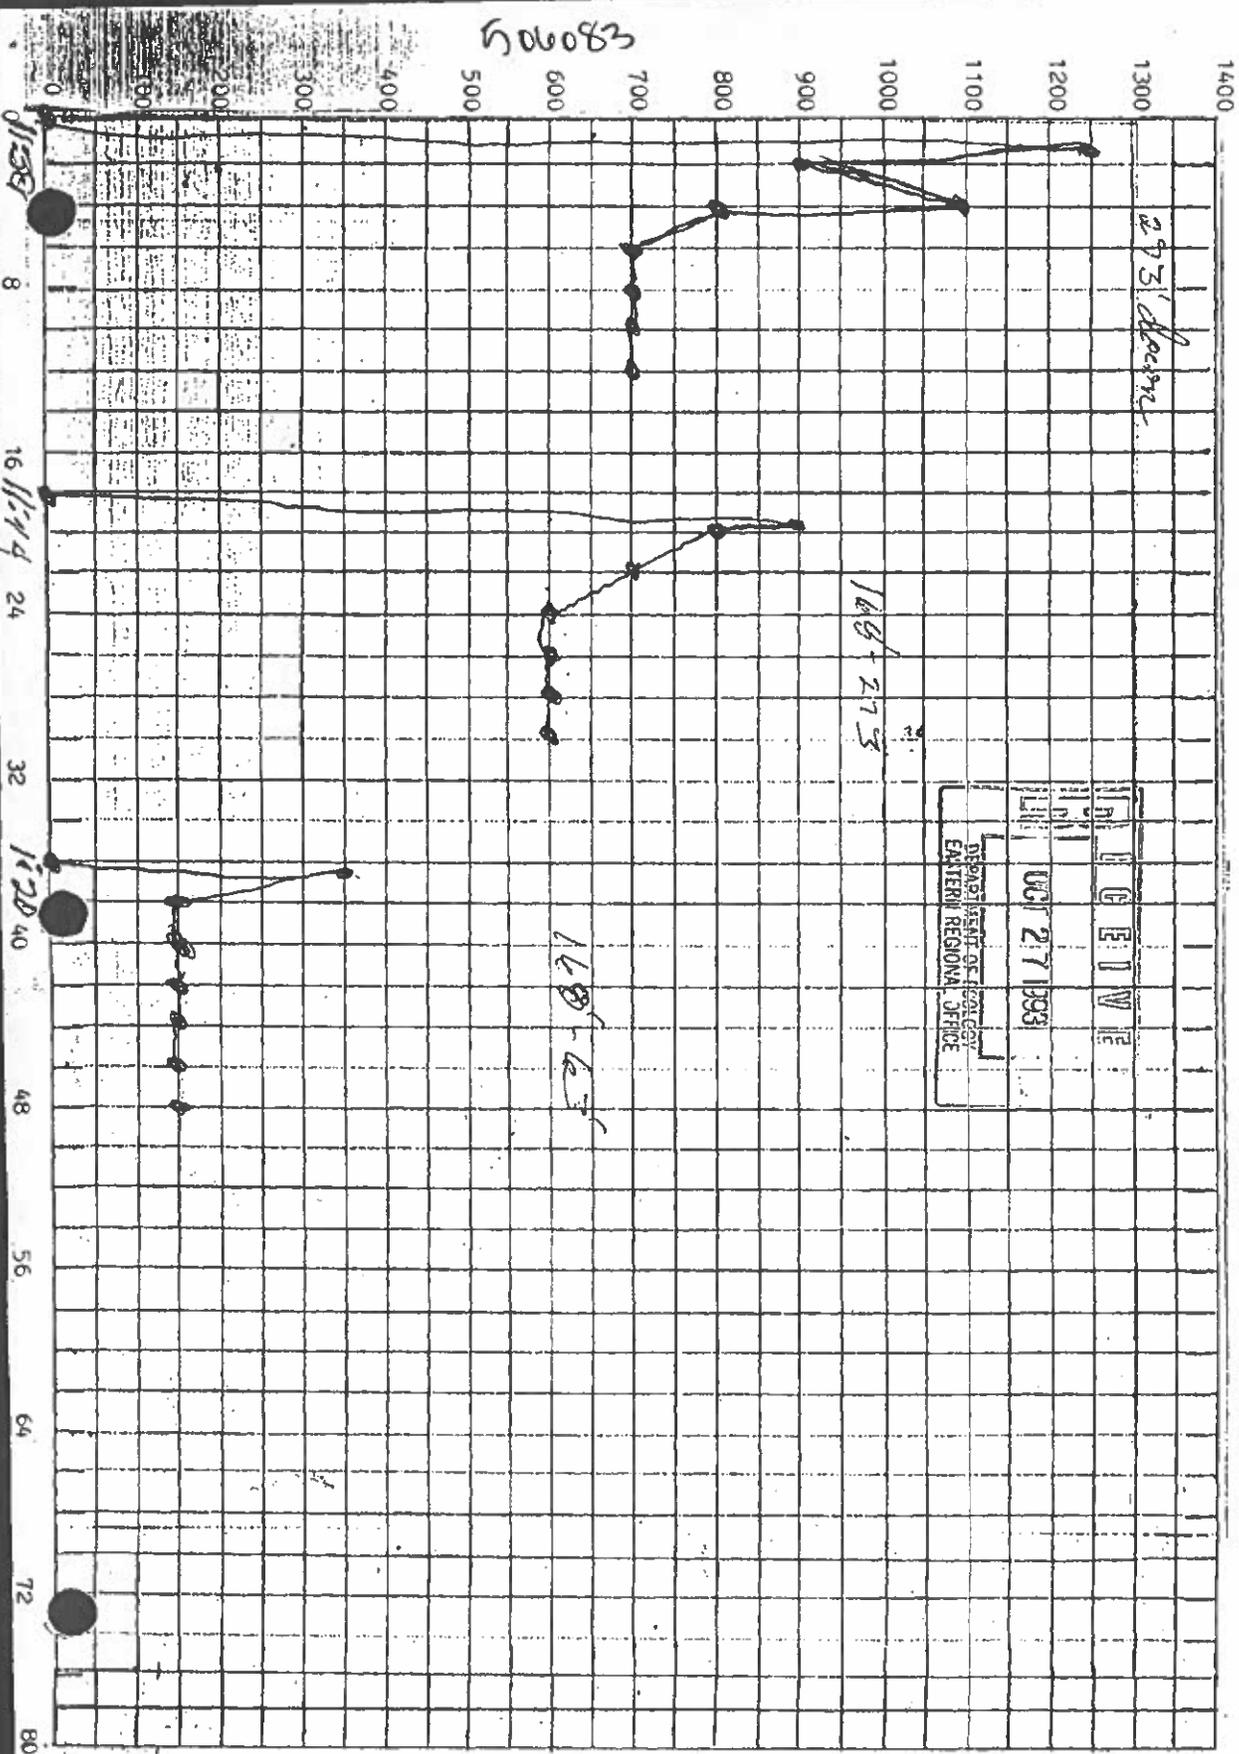


FIELD LOG  
 DATE: OCT 27 1983  
 DEPARTMENT OF ECOLOGY  
 EASTERN REGIONAL OFFICE



The Department of Ecology does NOT warrant the data and/or the information on this well report.

506083

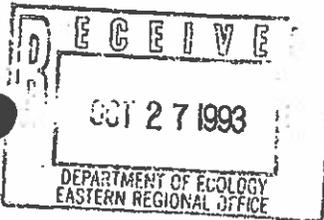

Permit No. W/22969

HYDRO-FRACTURING LOG

1. OWNER: Name Mike Bickle  
Address: 4177-D Hwy 395 N., Kettle Falls, WA 99141

Total depth 340 Diameter 6"

2. LOCATION OF WELL: County Stevens  
SE 1/4 SW 1/4 Sec. 2 T 36 N, R 37 WM

3. TYPE OF WORK: Hydro-fracturing

4. WELL TESTS:  
Yield: gal./min. with ft. drawdown after Hrs.  
Pre-frac: \_\_\_\_\_  
Post-frac: \_\_\_\_\_

5. HYDRO-FRACTURING LOG  
Hydrofractured at depths of:  
273 - 340 ft  
168 - 273 ft  
168 - 63 ft

6. HYDRO-FRACTURER'S STATEMENT:  
This well was hydro-fractured under my jurisdiction and this report is true to the best of my knowledge and belief.

Name Northwest Hydrofracturing  
Address W. 14010 Lincoln Road, Spokane, WA 99204  
Signed [Signature]  
Date 6-10-93

