

0N0002702

**NORTHEAST TRI COUNTY HEALTH DISTRICT  
DIVISION OF ENVIRONMENTAL HEALTH**

**ON-SITE SEWAGE SYSTEM PERMIT # PT0008473**

Robert & Arlene Nicholas is hereby authorized to utilize a sewage disposal system at  
(05/70)Tax #12 (PT S2 NE4 NE4); W2 NE4 NW4 NE4; W2 NW4 NE4; SE4 NW4 NE4; SW4 NE4; Tax#7 (PT SE4 NE4);  
E2 NW4; SW4 NW4; N2 NE4 SW4; Tax #9 (PT NW4 SE4)

Section: 15 Township: 36 Range: 37 Parcel #: 73615110003000

in accordance with the plans and specifications approved by the District Health Officer on file in this office

Prior to any major repairs, replacements or alterations to the system a permit shall be obtained from the NorthEast Tri  
County Health District (Division of Environmental Health).

This permit is issued and may be revoked by the NorthEast Tri County Health District Health Officer by authority of  
WAC 246-272, and Northeast Tri County Health District Regulations established by the Board of Health pursuant to  
RCW 70.05.

Additional permits from other jurisdictions or agencies may be necessary for this project It is the responsibility of the  
applicant to acquire said permit(s), and comply with all applicable rules, regulations and/or ordinances.



Date Issued: 06/18/2008

District Health Officer

**PERMIT INSTRUCTIONS**

STRUCTURE TYPE: Single-Family Residential

DFLF/BED DIMENSIONS:150

NUMBER OF BEDROOMS: 3

TRENCH DEPTH (inches): 36

DESIGN FLOW (gal/day): 360

TENCH WIDTH (inches): 36

TYPE OF SYSTEM: New

APPURTANENCES: Distribution Box, monitor

SYSTEM DESIGN: Gravity w/ Gravelless Cha

PUMP CHAMBER (y/n):

SEPTIC TANK CAPACITY (gal): 1000

PUMP CHAMBER GALLONS:

REASON SYSTEM DESIGN: Type 1 Exemption

SPECIAL PERMIT INSTRUCTIONS: Private shop connection. 25% reduction from 200' for chambers

FINAL INSPECTION DATE: 07/07/2008

Initials: *Bl*


\*\* SEE REVERSE FOR AS BUILT DRAWING

Stevens County Office	P.O.Box 270	Colville,	WA	99114	(509) 684-2262
Pend Oreille County Office	P.O. Box 490	Newport,	WA	99156	(509) 447-3131
Ferry County Office	P.O. Box 584	Republic,	WA	99166	(509) 775-3111

0 N 000 2702

# NORTHEAST TRI COUNTY HEALTH DISTRICT AS-BUILT DRAWING - PERMIT # PT-8473

INSPECTION DATE 7/7/08 INSPECTED BY BD APPROVED:  YES  NO

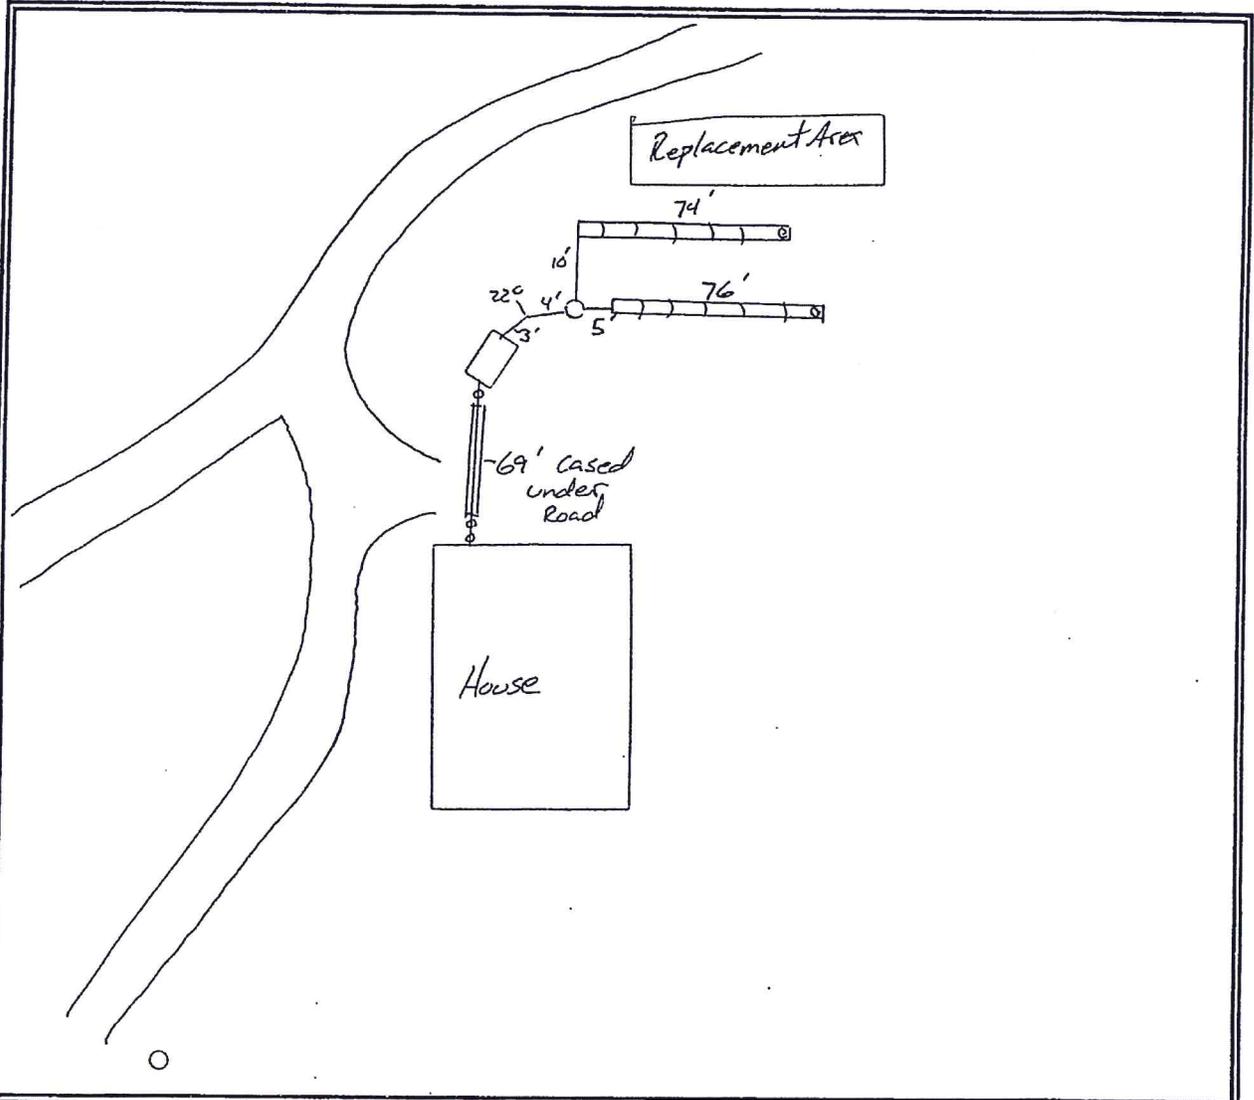

Installer Name Andy Matthews  
 Septic Tank Size 1000  
 Drainfield Length 150'  
 Drainfield Depth 36"

Pump Chamber Size \_\_\_\_\_  
 Doses/Day \_\_\_\_\_ Gallons/Dose \_\_\_\_\_  
 Squirt Height \_\_\_\_\_ Drawdown \_\_\_\_\_  
 Pump Run Time \_\_\_\_\_

(Revised 7/2003)