


SENTRY
DYNAMICS


STEVENS COUNTY
TITLE & ESCROW

This map/plat is being furnished as an aid in locating the herein described land in relation to adjoining streets, natural boundaries and other land, and is not a survey of the land depicted. Except to the extent a policy of title insurance is expressly modified by endorsement, if any, the company does not insure dimensions, distances, location of easements, acreage or other matters shown thereon.

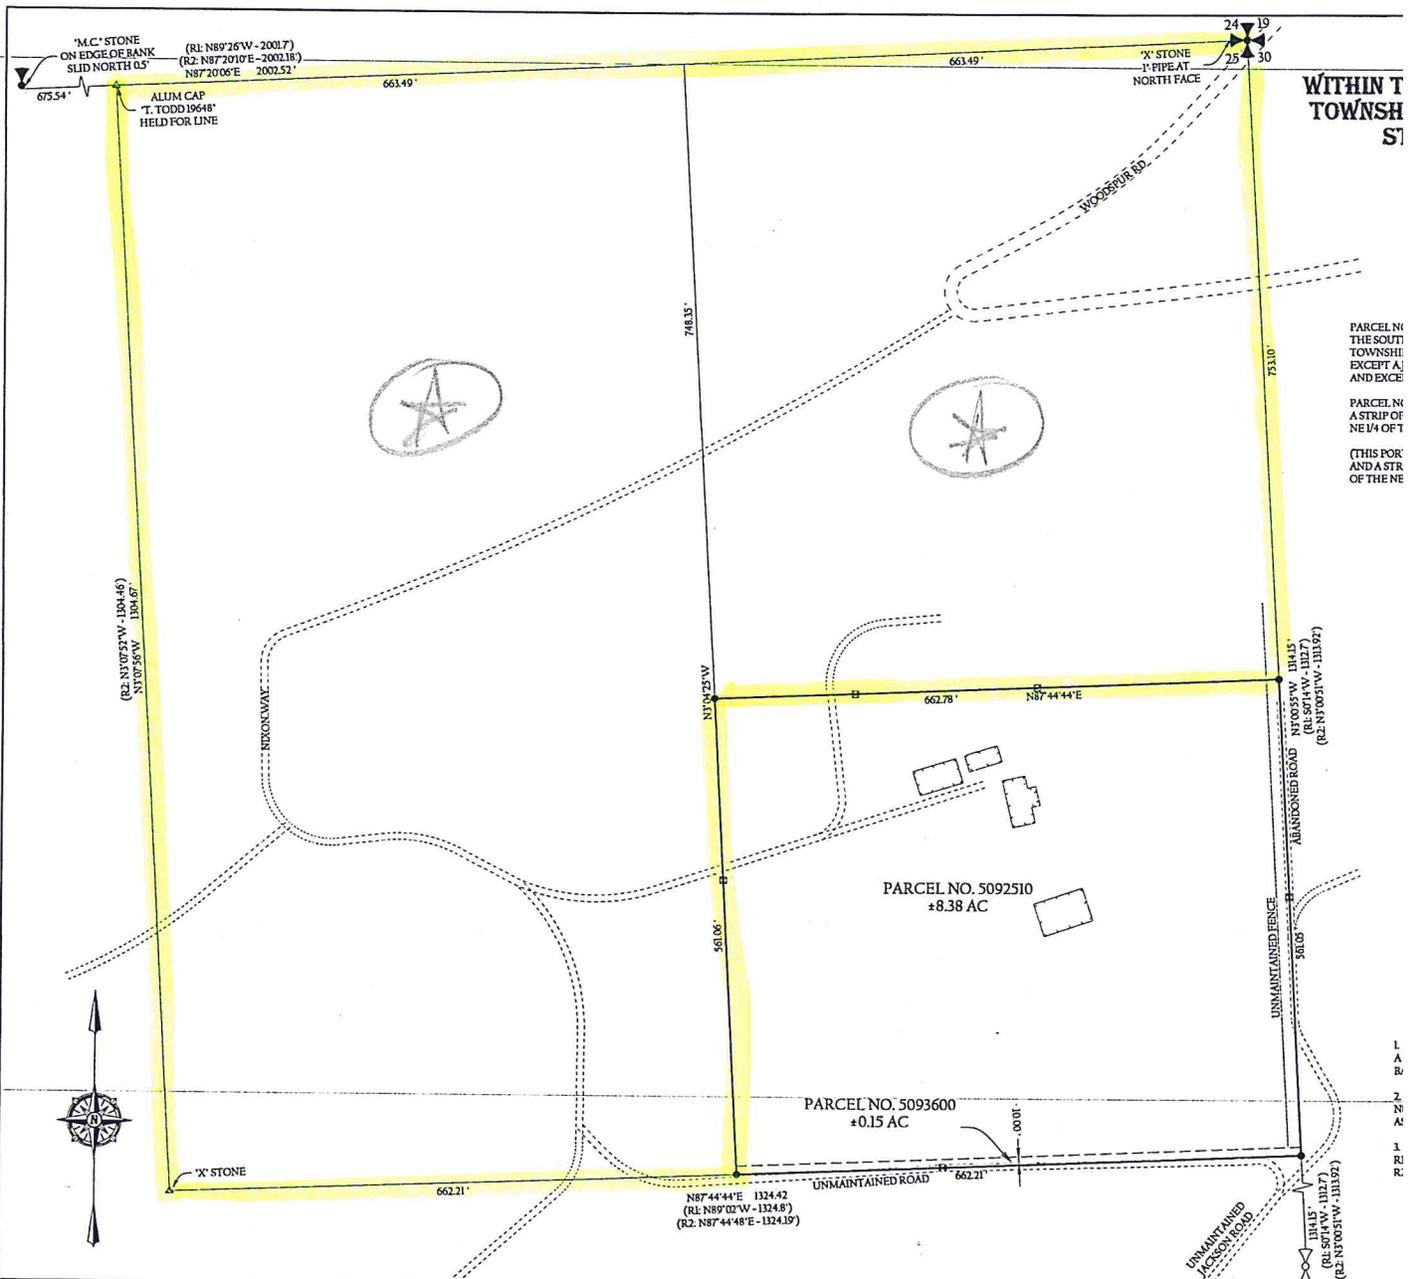

WITHIN T
TOWNSH
S]

PARCEL NO. THE SOUTH TOWNSHIP EXCEPT A AND EXCEPT A STRIP OF NE 1/4 OF T (THIS FOR AND A STRIP OF THE NE

L
A
B
2
N
A
3
R
R

CORNERSTONE SURVEYING INC
 800-B HWY 20 E.
 COLVILLE, WA 99114
 (509)-690-7334
 JAMESLEHRPLS@GMAIL.COM

SCALE 1" = 100'

MAP LEGEND

SECTION SUBDIVISION	CONTROLLING CORNER
LOT BOUNDARIES	FOUND AS NOTED
ASBUILT ROAD	SET 1/2" OR 5/8" REBAR
EXISTING FENCE	W/CAP JT/LIS 48760'
BUILDING	SET LINE STAKE

SURVEYOR'S CERTIFICATE

THIS MAP CORRECTLY REPRESENTS A SURVEY DONE BY ME OR UNDER MY DIRECTION IN CONFORMANCE WITH THE SURVEY RECORDING ACT. AT THE REQUEST OF GARY CASE.

JAMES THOMAS LEHR
 CERTIFICATE NO. 48760

STEVENS

FILED FOR RECORD IN BOOK 44 OF AT THE REQUEST OF Lori L. Larsen AUDITOR, STEVENS REC # 413-5