

NORTHEAST TRI COUNTY HEALTH DISTRICT
DIVISION OF ENVIRONMENTAL HEALTH

ON-SITE SEWAGE SYSTEM PERMIT # PT0003629

H. Leon Martin is hereby authorized to utilize a sewage disposal system at
Part of SE4 in section 6 and part of NE4 of section 7

Section: 6 Township: 37 Range: 39 Parcel #: 2322600 & 2322700

in accordance with the plans and specifications approved by the District Health Officer on file in this office.

Prior to any major repairs, replacements or alterations to the system a permit shall be obtained from the NorthEast Tri County Health District (Division of Environmental Health).

This permit is issued and may be revoked by the NorthEast Tri County Health District Health Officer by authority of WAC 246-272, and Northeast Tri County Health District Regulations established by the Board of Health pursuant to RCW 70.05.

Additional permits from other jurisdictions or agencies may be necessary for this project. It is the responsibility of the applicant to acquire said permit(s), and comply with all applicable rules, regulations and/or ordinances.

Date Issued: 06/09/2006



District Health Officer

PERMIT INSTRUCTIONS

STRUCTURE TYPE: Single-Family Residential

DFLF/BED DIMENSIONS: 150

NUMBER OF BEDROOMS: 3

TRENCH DEPTH (inches): 36

DESIGN FLOW (gal/day): 360

TRENCH WIDTH (inches): 36

TYPE OF SYSTEM: New

APPURTANENCES: Distribution Box

SYSTEM DESIGN: Gravity/gravelless chamber

PUMP CHAMBER (y/n): N

SEPTIC TANK CAPACITY (gal): 1000

PUMP CHAMBER GALLONS:

REASON SYSTEM DESIGN: Adequate soils

SPECIAL PERMIT INSTRUCTIONS: Optional effluent filter. 25% reduction from 200' for use of gravelless chambers.

FINAL INSPECTION DATE: 9-7-06

Initials: MS

** SEE REVERSE FOR AS BUILT DRAWING

Stevens County Office
Pend Oreille County Office
Ferry County Office

P.O.Box 270
P.O. Box 490
P.O. Box 584


Colville,
Newport,
Republic,

WA 99114
WA 99156
WA 99166

(509) 684-2262
(509) 447-3131
(509) 775-3111

NORTHEAST TRI COUNTY HEALTH DISTRICT
 AS-BUILT DRAWING - PERMIT # PT0003629

INSPECTION DATE 9-7-06 INSPECTED BY MS APPROVED: YES NO

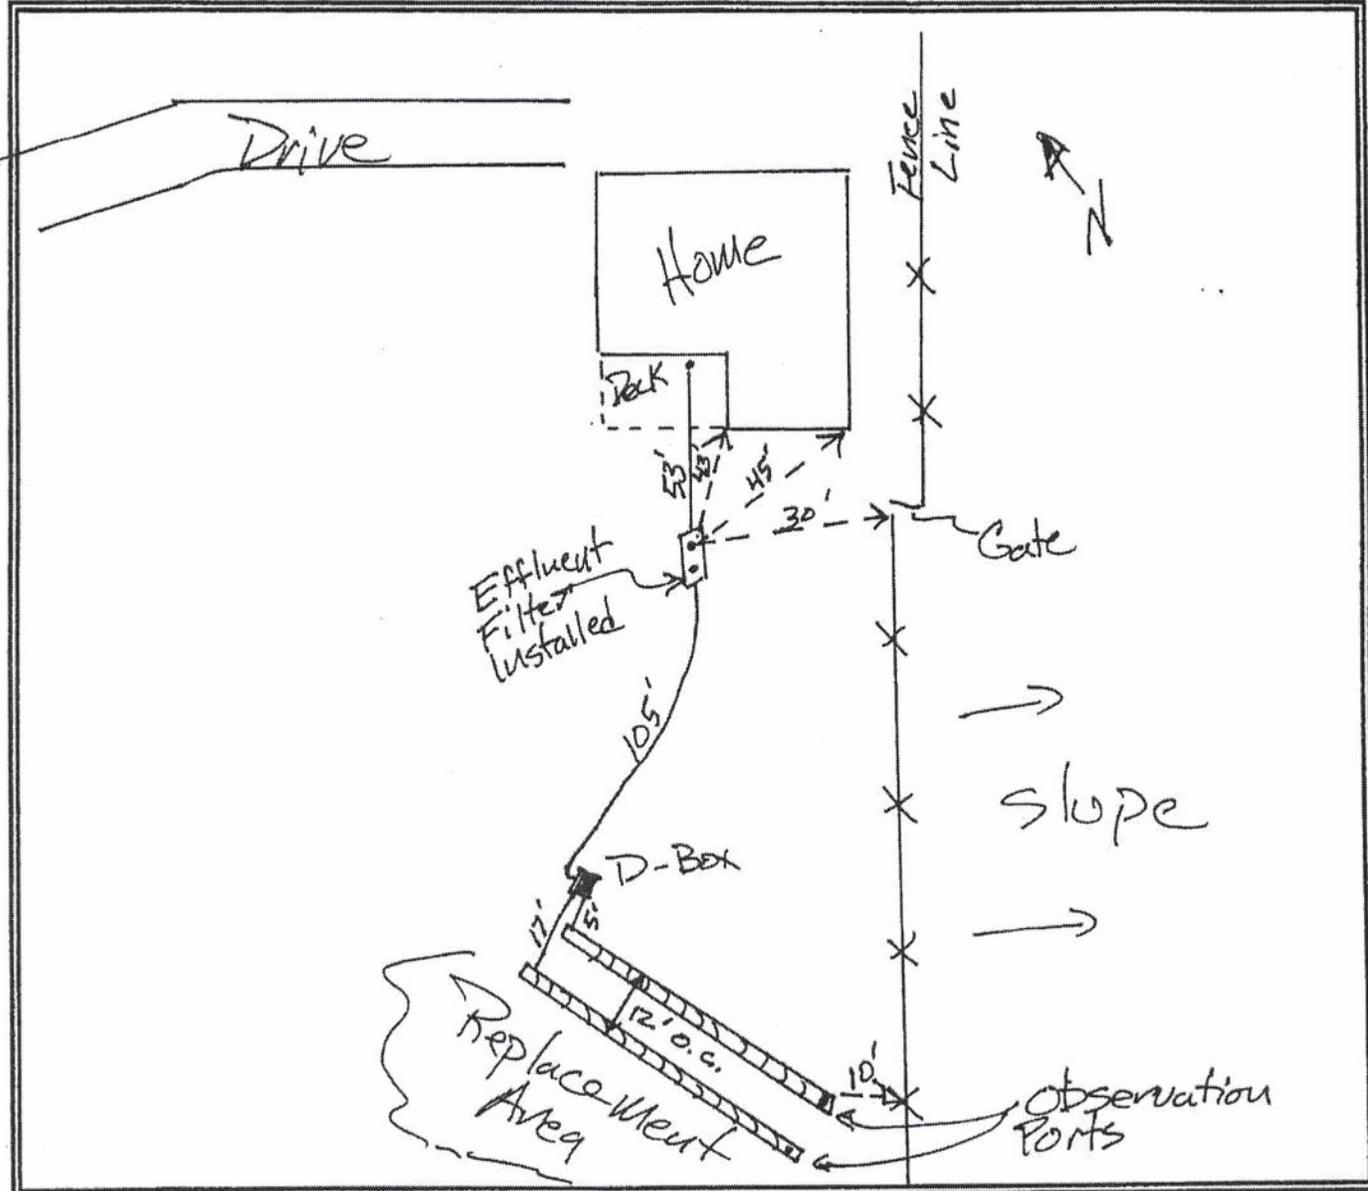

Installer Name Jim Mallery
 Septic Tank Size 1000
 Drainfield Length 150'
 Drainfield Depth 36"

Pump Chamber Size _____
 Doses/Day _____ Gallons/Dose _____
 Squirt Height _____ Drawdown _____
 Pump Run Time _____

(Revised 7/2003)