

SR 12641

NORTHEAST TRI COUNTY HEALTH DISTRICT  
DIVISION OF ENVIRONMENTAL HEALTH

ON-SITE SEWAGE SYSTEM PERMIT # PT0012591

Steve & Susan Olds is hereby authorized to utilize a sewage disposal system at  
S2 SW4, LS W 15'

Section: 2      Township: 31      Range: 39      Parcel #: 2093700

in accordance with the plans and specifications approved by the District Health Officer on file in this office.

Prior to any major repairs, replacements or alterations to the system a permit shall be obtained from the NorthEast Tri County Health District (Division of Environmental Health).

This permit is issued and may be revoked by the NorthEast Tri County Health District Health Officer by authority of WAC 246-272, and Northeast Tri County Health District Regulations established by the Board of Health pursuant to RCW 70.05.

Additional permits from other jurisdictions or agencies may be necessary for this project. It is the responsibility of the applicant to acquire said permit(s), and comply with all applicable rules, regulations and/or ordinances.

Date Issued: 05/17/2010



District Health Officer

PERMIT INSTRUCTIONS

STRUCTURE TYPE: Single-Family Residential

DFLF/BED DIMENSIONS: 200

NUMBER OF BEDROOMS: 3

TRENCH DEPTH (inches): 19

DESIGN FLOW (gal/day): 360

TENCH WIDTH (inches): 36

TYPE OF SYSTEM: Repair

APPURTANENCES: Effluent Filter

SYSTEM DESIGN: Pressure Distribution

PUMP CHAMBER (y/n): Y

SEPTIC TANK CAPACITY (gal):

PUMP CHAMBER GALLONS: 1000

REASON SYSTEM DESIGN: Type 1 soils @ shallow de

SPECIAL PERMIT INSTRUCTIONS:

FINAL INSPECTION DATE: 5/21/10

Initials: MS

\*\* SEE REVERSE FOR AS BUILT DRAWING

Stevens County Office  
Pend Oreille County Office  
Ferry County Office

260 S. Oak  
605 Hwy 20  
P.O. Box 584


Colville, WA 99114  
Newport, WA 99156  
Republic, WA 99166

(509) 684-2262  
(509) 447-3131  
(509) 775-3111

SR 12641

NORTHEAST TRI COUNTY HEALTH DISTRICT  
AS-BUILT DRAWING - PERMIT # PT0012591

INSPECTION DATE 5/21/10 INSPECTED BY MS APPROVED:  YES  NO

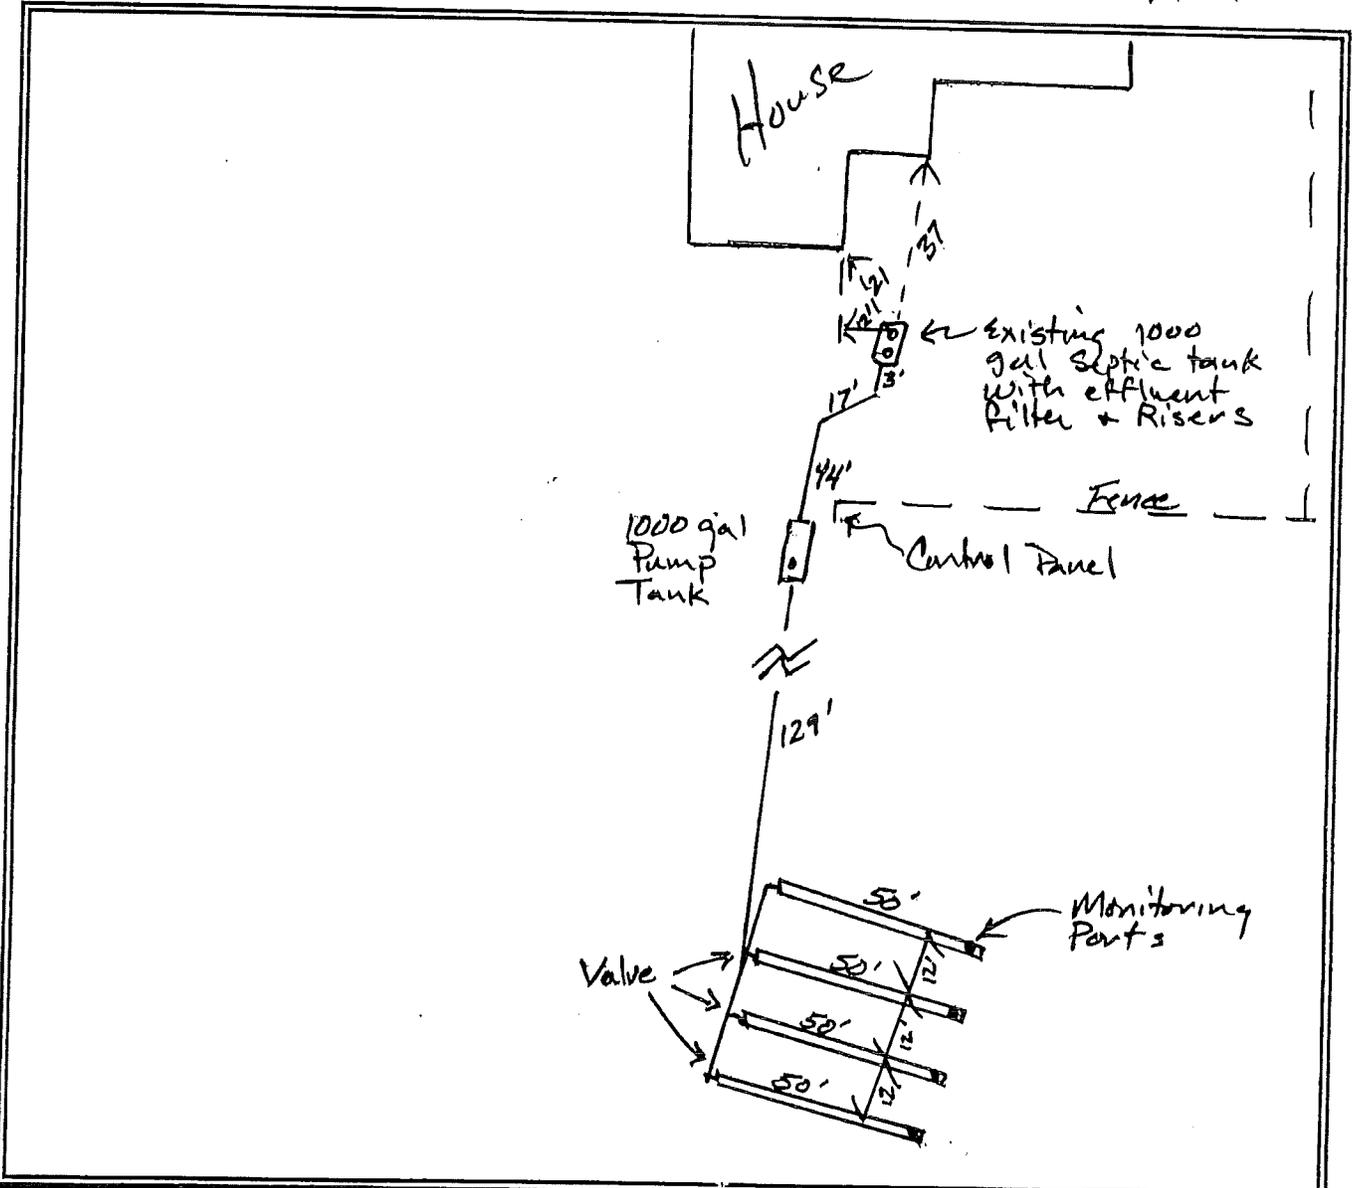

Installer Name Mark Herbes  
Septic Tank Size 1000  
Drainfield Length 200'  
Drainfield Depth 19'

Pump Chamber Size 1000  
Doses/Day 3 Gallons/Dose 120  
Squirt Height 42" Drawdown 5.5"  
Pump Run Time 2 min 34 sec