

NORTHEAST TRI COUNTY HEALTH DISTRICT
DIVISION OF ENVIRONMENTAL HEALTH

ON-SITE SEWAGE SYSTEM PERMIT # PT0019761

Dwight Johnson is hereby authorized to utilize a sewage disposal system at
KETTLE FALLS WIZARD LOTS 23-32 BLK 2

Section: 26 Township: 36 Range: 37 Parcel #: 0379200

in accordance with the plans and specifications approved by the District Health Officer on file in this office.

Prior to any major repairs, replacements or alterations to the system a permit shall be obtained from the Northeast Tri County Health District (Division of Environmental Health).

This permit is issued and may be revoked by the Northeast Tri County Health District Health Officer by authority of WAC 246-272, and Northeast Tri County Health District Regulations established by the Board of Health pursuant to RCW 70.05.

Additional permits from other jurisdictions or agencies may be necessary for this project. It is the responsibility of the applicant to acquire said permit(s), and comply with all applicable rules, regulations and/or ordinances.



Date Issued: 04/08/2021

District Health Officer

PERMIT INSTRUCTIONS

STRUCTURE TYPE: Single-Family Residential

NUMBER OF BEDROOMS: 3

DESIGN FLOW (gal/day): 360

TYPE OF SYSTEM: New

SYSTEM DESIGN: Gravity w/ Gravelless Chambers

SEPTIC TANK CAPACITY(gal): 1000

DFLF/BED DIMENSIONS: 152

TRENCH DEPTH (inches): 36

TRENCH WIDTH (inches): 36

APPURTENANCES: D-Box & Effluent Filter

PUMP CHAMBER (y/n):

PUMP CHAMBER GALLONS:

REASON FOR SYSTEM DESIGN: 24% reduction from 200' for chambers

SPECIAL PERMIT INSTRUCTIONS:

FINAL INSPECTION DATE: 4/12/21

Initials: BH


Stevens County Office	240 E Dominion	Colville,	WA	99114	(509) 684-2262
Pend Oreille County Office	605 Hwy 20	Newport,	WA	99156	(509) 447-3131
Ferry County Office	P.O. Box 584	Republic,	WA	99166	(509) 775-3111



On-Site Sewage System As-Built Drawing for Permit # PT 1974

Inspection Date	4/12/21	Approved <input checked="" type="checkbox"/> Yes <input type="checkbox"/> No	Approved Date	4/12/21
Inspection By	BJH		Re-Inspection Date	

* Public water System

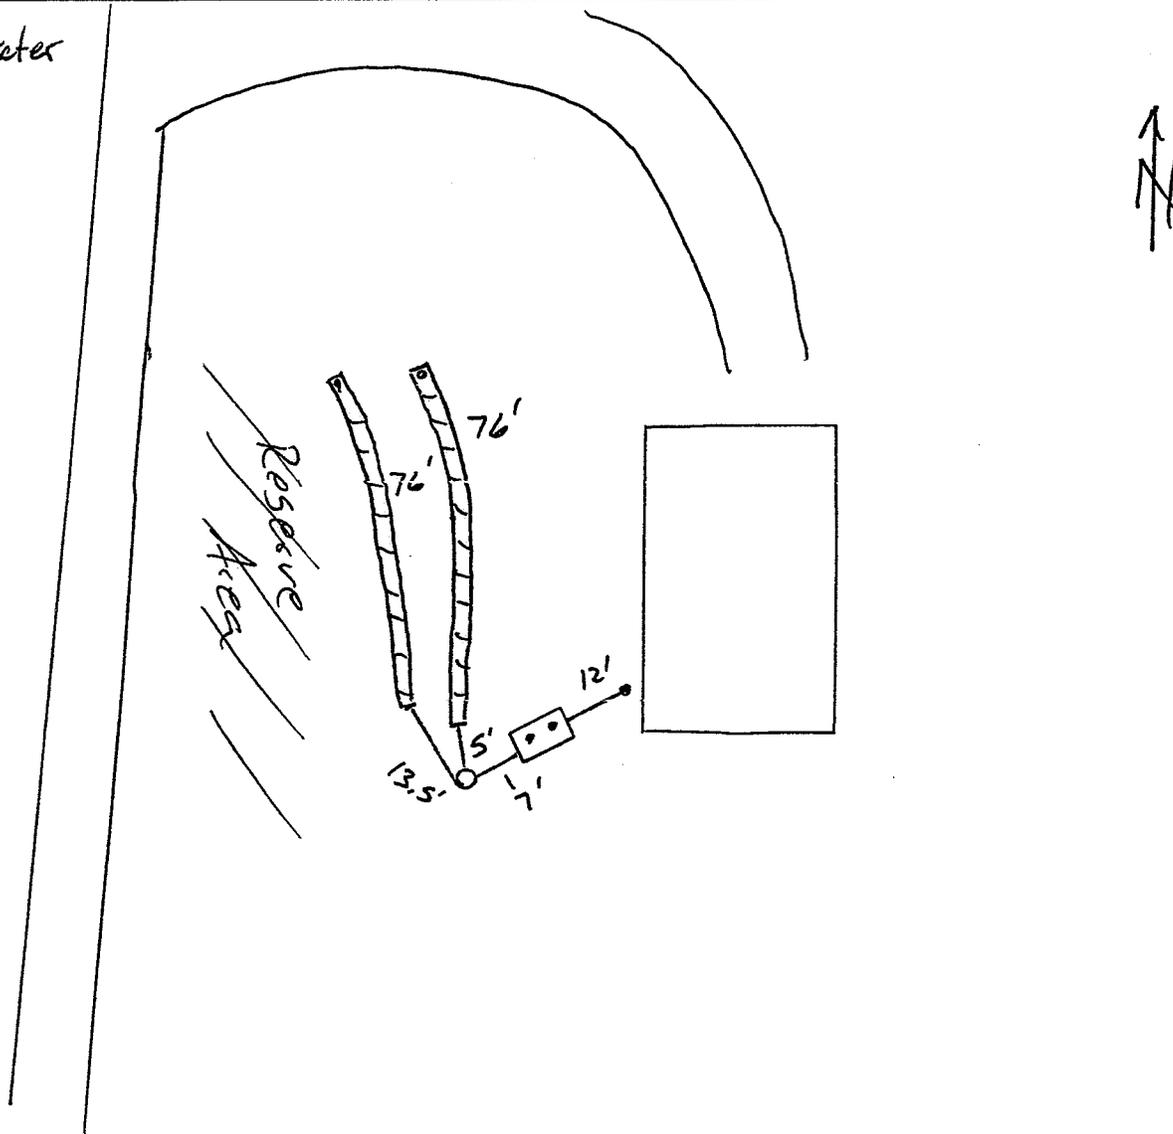

Installer Name	Dave Engell		Pump Chamber Size	
Septic Tank Size	1000	Dose/day		Gallons/Dose
Drainfield Length	152'	Squirt Height		Drawdown
Drainfield Depth	36"	Pump Run Time		
Septic Tank Latitude/Longitude	48.58762 / -118.10911			