

SK 1407

5000097
21-20

**NORTHEAST TRI COUNTY HEALTH DISTRICT
DIVISION OF ENVIRONMENTAL HEALTH
ON-SITE SEWAGE SYSTEM PERMIT # 5000097**

James Pettit is hereby authorized to utilize a sewage disposal system at
TAX #5


Section: 27 Township: 32 Range: 37 Parcel #: 1627100

in accordance with the plans and specifications approved by the District Health Officer on file in this office.

Prior to any major repairs, replacements or alterations to the system a permit shall be obtained from the Northeast Tri County Health District (Division of Environmental Health).

This permit is issued and may be revoked by the Northeast Tri County Health District Health Officer by authority of WAC 246-272, and Northeast Tri County Health District Regulations established by the Board of Health pursuant to RCW 70.05.

Additional permits from other jurisdictions or agencies may be necessary for this project. It is the responsibility of the applicant to acquire said permit (s), and comply with all applicable rules, regulations and/or ordinances.

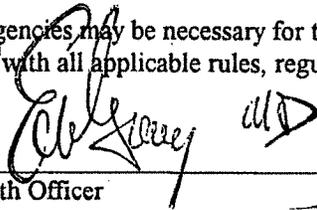

District Health Officer

Date Issued: 06/05/1998

PERMIT INSTRUCTIONS

STRUCTURE TYPE: **Single Family Residence**
NUMBER OF BEDROOMS: **3**
DESIGN FLOW (gal/day): **360**
TYPE OF SYSTEM: **New**
SYSTEM DESIGN: **Conventional Gravity**
SEPTIC TANK CAPACITY (gal): **1000**
REASON SYSTEM DESIGN: **Type 5 soils**

DFLF/BED DIMENSIONS: **300'**
TRENCH DEPTH (inches): **36**
TRENCH WIDTH (inches): **36**
APPURTANENCES: **D- Box**
PUMP CHAMBER (y/n): **N**
PUMP CHAMBER GALLONS: **0**

SPECIAL PERMIT INSTRUCTIONS:

FINAL INSPECTION DATE: 7 / 22 / 98

INITIALS: 

**** SEE REVERSE FOR AS BUILT DRAWING**

- | | | | |
|------------------------------|--------------|--------------------|----------------|
| * Stevens County Office | P.O. Box 270 | Colville, WA 99114 | (509) 684-2262 |
| * Pend Oreille County Office | P.O. Box 490 | Newport, WA 99156 | (509) 447-3131 |
| * Ferry County Office | P.O. Box 584 | Republic, WA 99166 | (509) 775-3111 |

1/31/02 now known as Tax #20, SP 56-98-2

SR1409




FINAL AS-BUILT DRAWING - PERMIT # 500097

DATE OF FINAL INSPECTION 7/22/98 BY DJ

Bissell Rd
Court Nelson

Bissell Rd.

Driveway

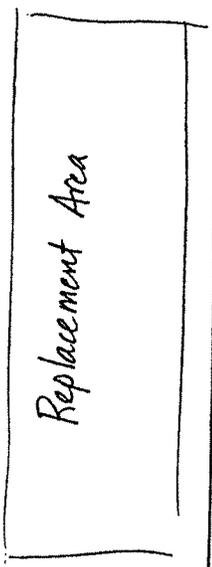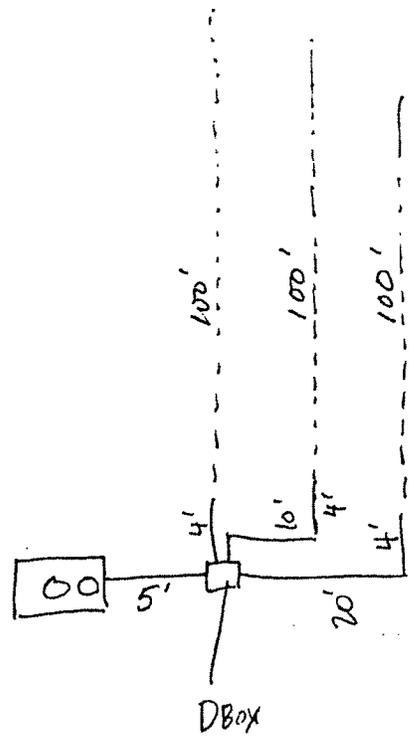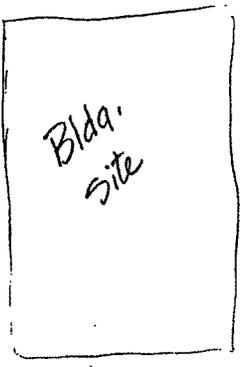

Andy Matthews, installer
300' d.f.
1000 gal. tank

~~well~~

well