
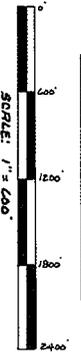




21 22 689.37 S71°E - 2648.95
 27 28 FOUND OUR MONUMENTARY PEAR Book 19 OF SURVEYS OF PAGES 94-103
 589.28 S02°E - 2102.89
 C 387.08 S00°E - 2102.89
 MERRY 1/4 CORNER FOUND MONUMENTARY PEAR Book 24, SURVEYS, PG. 116

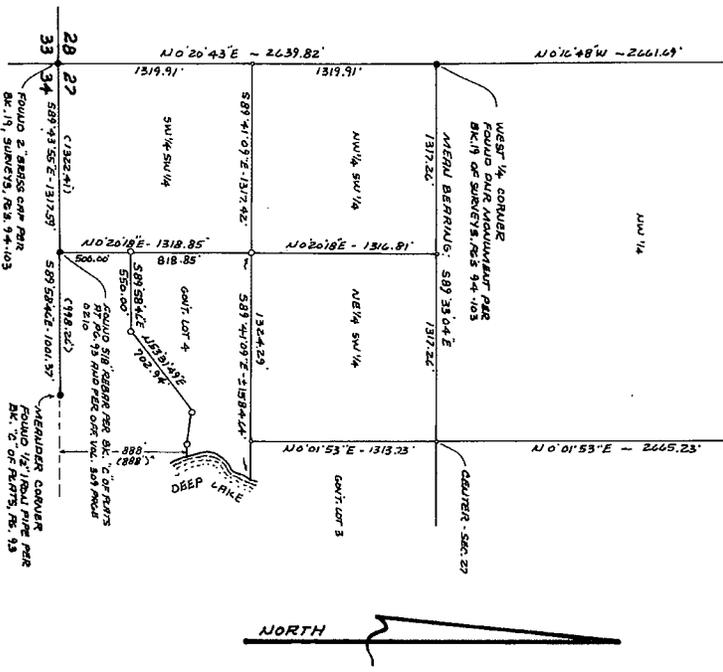

SURVEYOR'S CERTIFICATE

THIS MAP CORRECTLY REPRESENTS A SURVEY MADE BY ME OR UNDER MY DIRECTION IN CONFORMANCE WITH THE REQUIREMENTS OF THE SURVEY RECORDING ACT AT THE REQUEST OF THOMAS E. TODD FOR RECORD BEARING & RESURVEY GRANT IN APRIL 2007 - JULY 2007.

THOMAS E. TODD, L.S., 19649
 THOMAS E. TODD LAND SURVEYOR, LLC
 455 SOUTH OAK STREET
 COLVILLE, WA. 99114
 (509) 684-8661

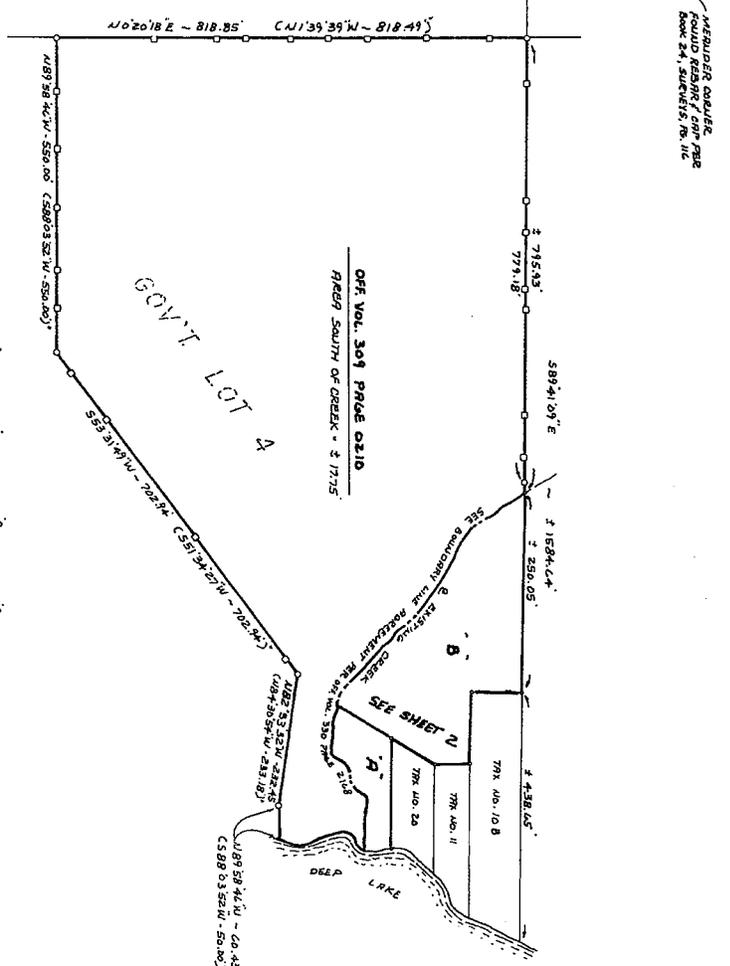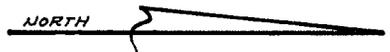

LEGEND

- SET 5/8" REBAR WITH 1 1/4" ANCH. CAP
 - SET HUB AND LATH ON LINE
 - ◇ NO MONUMENT FOUND OR SET
 - FOUND MONUMENT AS INDICATED
 - RECORD DATA PER OFF. VOL. 309 PAGE 0210
 - (.....) RECORD DATA
- FIELD TRAVERSE USING TOPCON 235W
 BASIS OF BEARINGS: BOOK 24 OF SURVEYS AT PAGE 116

AUDITOR'S CERTIFICATE


2007 0008270
 FILED FOR RECORD THIS 20TH DAY OF July, 2007,
 AT _____, IN BOOK _____ OF SURVEYS AT PAGE _____,
 AT THE REQUEST OF THOMAS E. TODD.

Tim Gray FEE 408.00
 COUNTY AUDITOR DEPUTY AUDITOR

RECORD OF SURVEY

IN GOVERNMENT LOT 4 OF SECTION 27, T. 39 N., R. 41 E., W. N., STEVENS COUNTY, WASHINGTON.

100 367 P. 1188

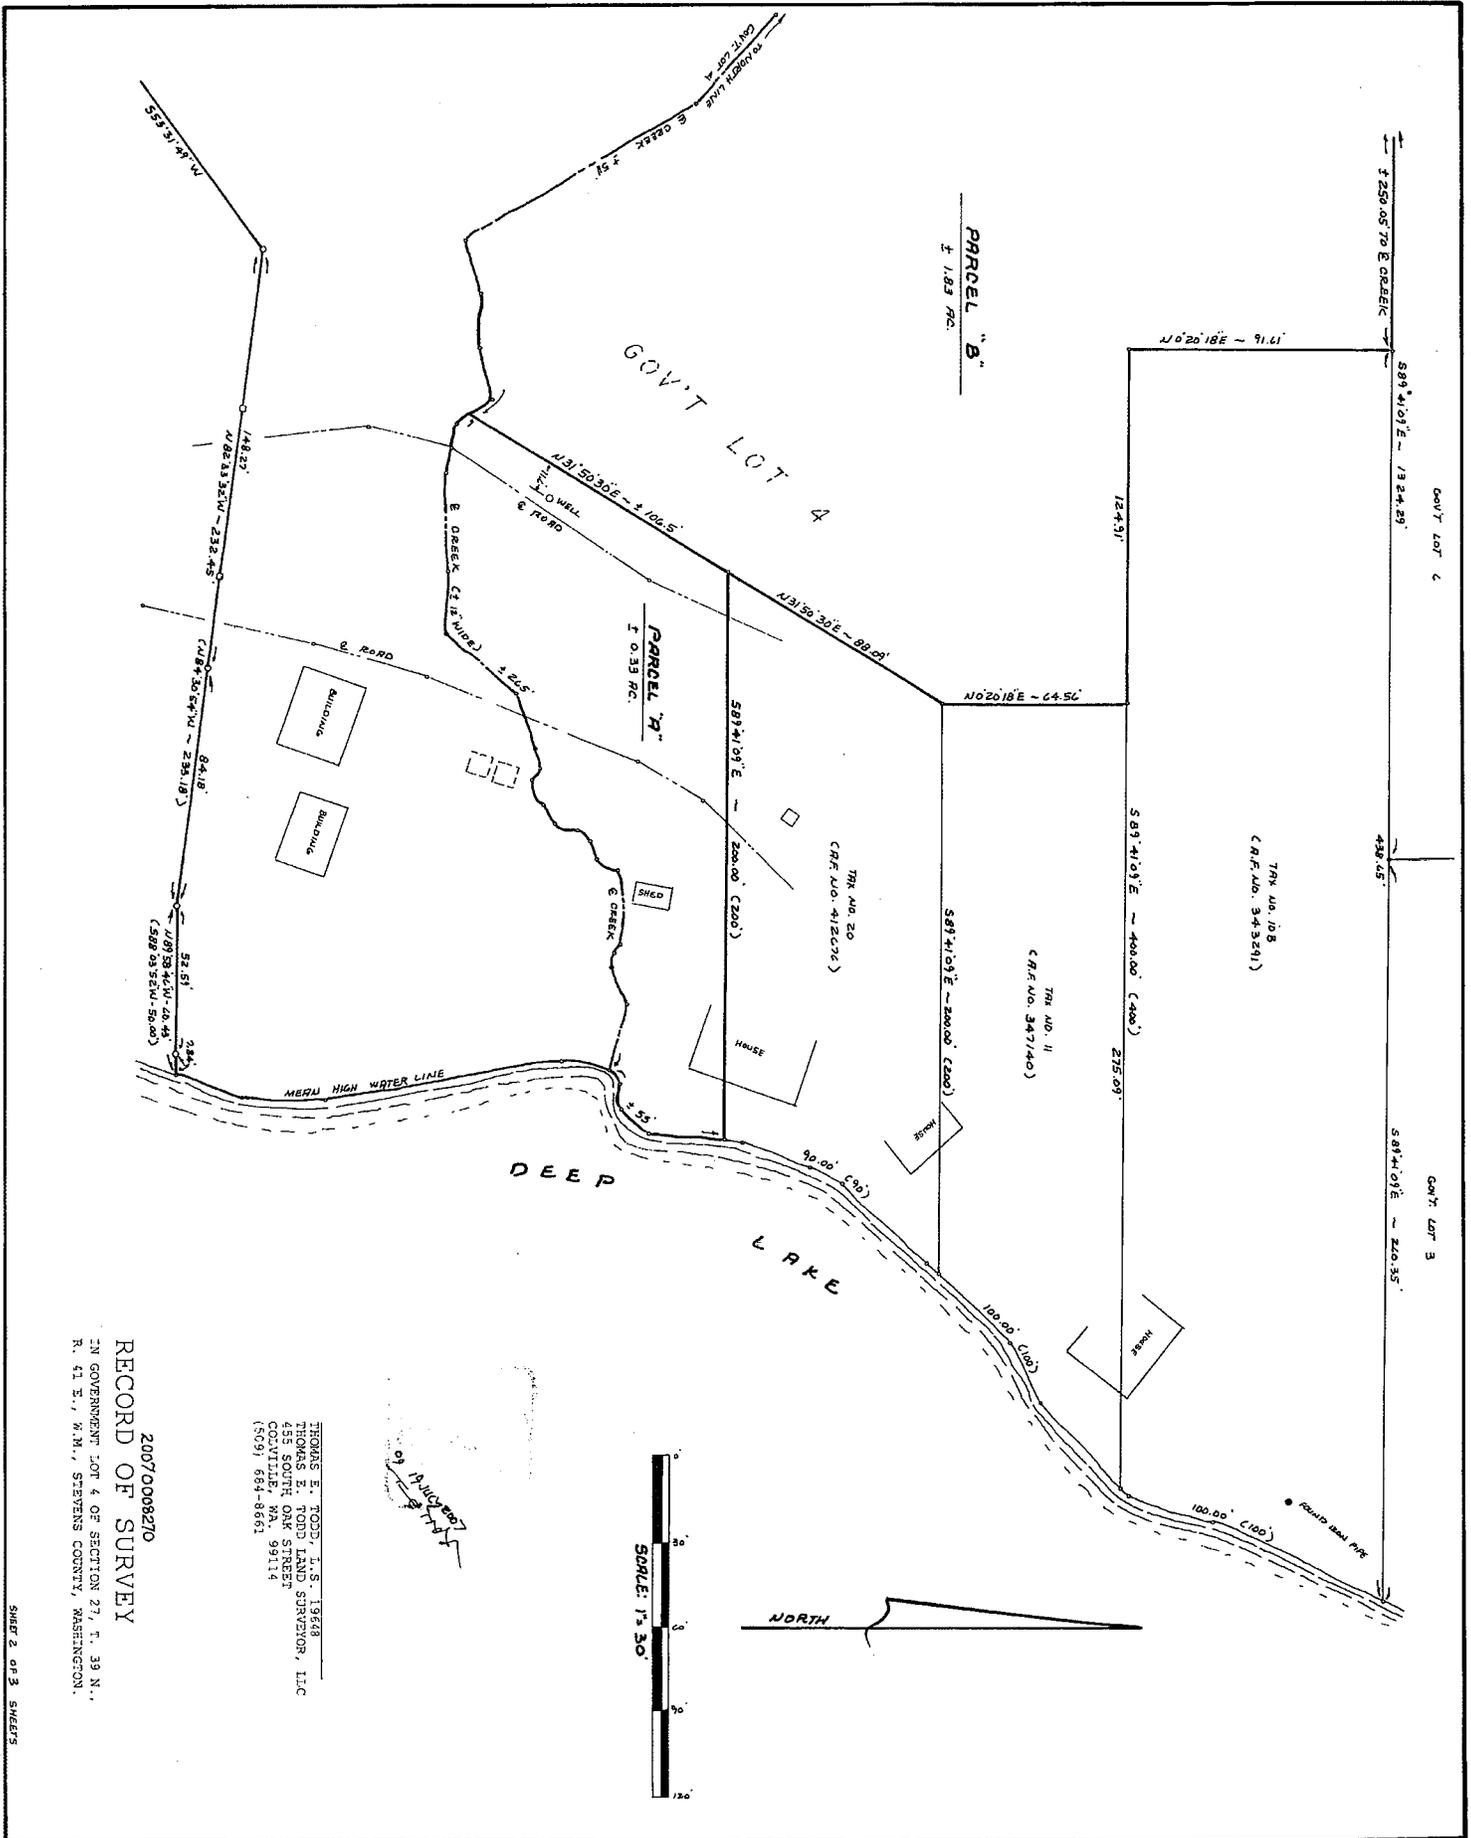

RECORD OF SURVEY

20070008270

IN GOVERNMENT LOT 4 OF SECTION 27, T. 39 N., R. 43 E., W.M., STEVENS COUNTY, WASHINGTON.

THOMAS E. TODD, I.S. 13678
 THOMAS E. TODD LAND SURVEYOR, LLC
 455 SOUTH ORK STREET
 COVILLE, WA. 99114
 (509) 684-8861

PARCEL "A" (TO BE ATTACHED TO TAX NO. 20)

THAT PART OF GOVERNMENT LOT 4 OF SECTION 27, T. 39 N., R. 41 E., W. 3., STEVENS COUNTY, WASHINGTON, DESCRIBED AS FOLLOWS: COMMENCING AT THE NORTHWEST CORNER OF SAID GOVERNMENT LOT 4; THENCE, ALONG THE NORTH LINE THEREOF, S 89°41'09" E 1045.98 FT., TO THE NORTHWEST CORNER OF THAT TRACT OF LAND DESCRIBED IN THAT DEED RECORDED UNDER AUDITOR'S FILE NO. 343291 (TAX NO. 10B); THENCE, LEAVING THE NORTH LINE SAID GOVERNMENT LOT 4 AND THE WEST LINE SAID TRACT OF LAND DESCRIBED IN THAT DEED RECORDED UNDER AUDITOR'S FILE NO. 347140 (TAX NO. 11); THENCE, ALONG THE SOUTH LINE OF SAID TAX NO. 10B, S 89°41'09" E 124.91 FT., TO THE NORTHWEST CORNER OF THAT TRACT OF LAND DESCRIBED IN THAT DEED RECORDED UNDER AUDITOR'S FILE NO. 347140 (TAX NO. 11); THENCE, LEAVING THE SOUTH LINE OF SAID TAX NO. 11, S 0°20'18" W 64.56 FT., TO THE SOUTHWEST CORNER OF THAT TRACT OF LAND DESCRIBED IN THAT MODIFICATION AGREEMENT RECORDED UNDER AUDITOR'S FILE NO. 412676 (TAX NO. 20); THENCE, ALONG THE WESTERLY LINE OF SAID TAX NO. 20, S 31°50'30" W 88.09 FT., TO THE SOUTHWEST CORNER OF SAID TAX NO. 20; THENCE, ALONG THE SOUTHWESTERLY PROJECTION OF THE WESTERLY LINE OF SAID TAX NO. 20, S 31°50'30" W 106.50 FT., MORE OR LESS, TO THE CENTERLINE OF AN EXISTING CREEK, THENCE, ALONG THE CENTERLINE SAID CREEK, S 20°00'00" W 265.00 FT., MORE OR LESS, TO THE MEAN HIGHWATER LINE OF DEEP LAKE, THENCE, ALONG THE MEAN HIGHWATER LINE OF SAID DEEP LAKE, NORTHEASTERLY 55 FT., MORE OR LESS, TO THE SOUTHEAST CORNER OF SAID TAX NO. 20; THENCE, ALONG THE SOUTH LINE OF SAID TAX NO. 20, N 89°41'09" W 200.00 FT., TO THE POINT OF BEGINNING.

PARCEL "B" (IGNORE TO BEDEES)

THAT PART OF GOVERNMENT LOT 4 OF SECTION 27, T. 39 N., R. 41 E., W. 3., STEVENS COUNTY, WASHINGTON, DESCRIBED AS FOLLOWS:

COMMENCING AT THE NORTHWEST CORNER OF SAID GOVERNMENT LOT 4; THENCE, ALONG THE NORTH LINE THEREOF, S 89°41'09" E 795.93 FT., MORE OR LESS, TO THE CENTERLINE OF AN EXISTING CREEK AND THE POINT OF BEGINNING FOR THIS DESCRIPTION; THENCE, CONTINUING ALONG THE NORTH LINE OF SAID GOVERNMENT LOT 4, S 89°41'09" E 250.05 FT., MORE OR LESS, TO THE NORTHWEST CORNER OF THAT TRACT OF LAND DESCRIBED IN THAT DEED RECORDED UNDER AUDITOR'S FILE NO. 343291 (TAX NO. 10B); THENCE, LEAVING THE NORTH LINE SAID GOVERNMENT LOT 4 AND ALONG THE WEST LINE OF SAID TAX NO. 10B, S 0°20'18" W 91.61 FT., TO THE SOUTHWEST CORNER THEREOF; THENCE, ALONG THE SOUTH LINE OF SAID TAX NO. 10B, S 89°41'09" E 124.91 FT., TO THE NORTHWEST CORNER OF THAT TRACT OF LAND DESCRIBED IN THAT DEED RECORDED UNDER AUDITOR'S FILE NO. 347140 (TAX NO. 11); THENCE, LEAVING THE SOUTH LINE OF SAID TAX NO. 10B AND ALONG THE WEST LINE OF SAID TAX NO. 11, S 0°20'18" W 64.56 FT., TO THE SOUTHWEST CORNER THEREOF, SAID POINT BEING THE NORTHWEST CORNER OF THAT TRACT OF LAND DESCRIBED IN THAT MODIFICATION AGREEMENT RECORDED UNDER AUDITOR'S FILE NO. 412676 (TAX NO. 20); THENCE, ALONG THE WESTERLY LINE OF SAID TAX NO. 20, S 31°50'30" W 88.09 FT., TO THE SOUTHWEST CORNER OF SAID TAX NO. 20; THENCE, ALONG THE SOUTHWESTERLY PROJECTION OF THE WESTERLY LINE OF SAID TAX NO. 20, S 31°50'30" W 106.50 FT., MORE OR LESS, TO THE CENTERLINE OF AN EXISTING CREEK, THENCE, ALONG THE CENTERLINE SAID CREEK, WESTERLY, AND NORTHWESTERLY, 511 FT., MORE OR LESS, TO THE POINT OF BEGINNING.



THOMAS S. TODD, L.S. 19648
THOMAS S. TODD LAND SURVEYOR, LLC
C/O SUTHER OAK STREET
1001 SUTHER OAK STREET
COVINGTON, WA 99124
(509) 884-8661

20070008270

RECORD OF SURVEY

IN GOVERNMENT LOT 4 OF SECTION 27, T. 39 N., R. 41 E., W. 3., STEVENS COUNTY, WASHINGTON.