

SR 5560

Septic Tank	1000	Gals.
Disp. Field	180'	L.F.T
Other	_____	
( ) New	_____	
( ) Repair	_____	

**NORTHEAST TRI-COUNTY HEALTH DISTRICT**  
**Division of Environmental Health**  
 ( ) Colville Office, Box 270, Phone 684-2262  
 ( ) Newport Office, Box 490, Phone 447-3175  
 ( ) Republic Office, Box 584, Phone 775-2374

6854  
285-50

Permit No. 0854  
 Fee Paid 10.00 Rec. # 5877

Stanley Rotmark is hereby authorized to utilize a sewage disposal system at 1/4 of the SW 1/4 of the NW 1/4 Sec. 36; Twp. 35; Rge. 38 and in accordance with the plans and specifications approved by the District Health Officer on file in this office.


Any major repairs or alterations to the system shall be reported to the Northeast Tri-County Health District (Division of Environmental Health) for approval PRIOR to construction.

This permit is issued and may be revoked by the Northeast Tri-County Health District Health Officer by the authority of WAC 248-96, and Rules and Regulations established by the Board pursuant to RCW 70.05.

Witness my hand and seal this 21 day of September, 19 78.

Date of Inspection 11/2/78 \_\_\_\_\_  
 District Health Officer

SR 5560

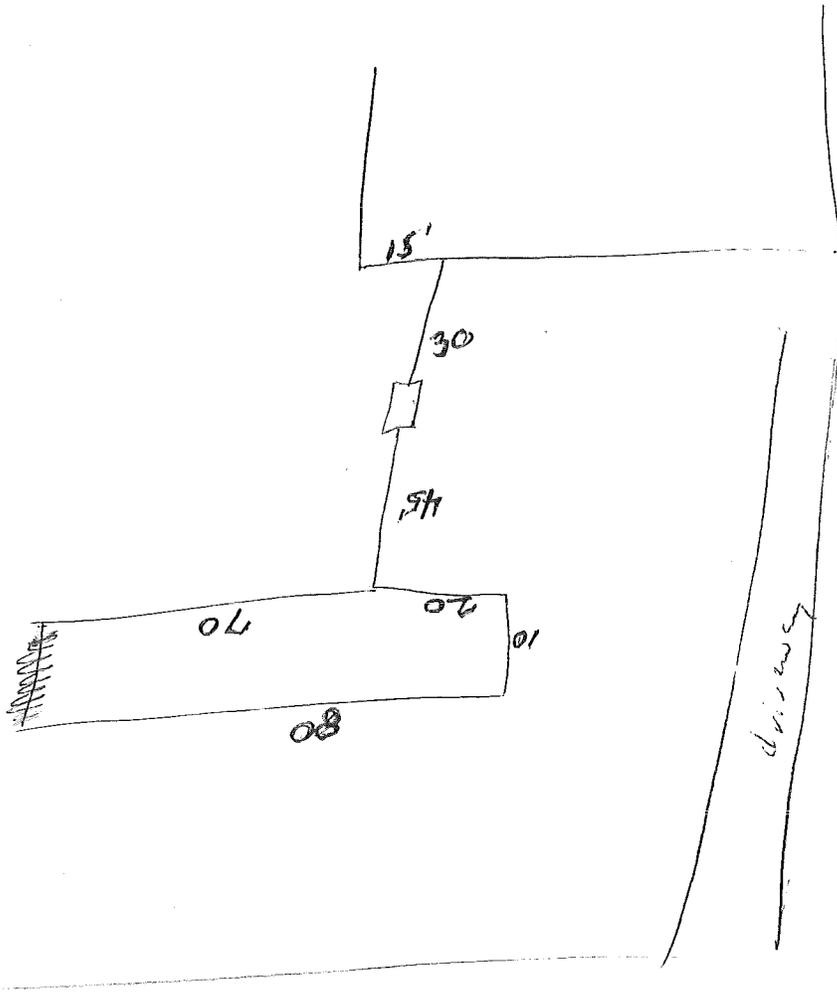

road