

JK4482

**NORTHEAST TRI COUNTY HEALTH DISTRICT  
DIVISION OF ENVIRONMENTAL HEALTH  
ON-SITE SEWAGE SYSTEM PERMIT # 5000924**

5000924

85-54-38

Irvin Naff is hereby authorized to utilize a sewage disposal system at  
LS TAX 1, 2 S RD 2150 & SE RD 2746 SW4 SW4


Section: 25 Township: 34 Range: 38 Parcel #: 1865000

in accordance with the plans and specifications approved by the District Health Officer on file in this office.

Prior to any major repairs, replacements or alterations to the system a permit shall be obtained from the Northeast Tri County Health District (Division of Environmental Health).

This permit is issued and may be revoked by the Northeast Tri County Health District Health Officer by authority of WAC 246-272, and Northeast Tri County Health District Regulations established by the Board of Health pursuant to RCW 70.05.

Additional permits from other jurisdictions or agencies may be necessary for this project. It is the responsibility of the applicant to acquire said permit (s), and comply with all applicable rules, regulations and/or ordinances.

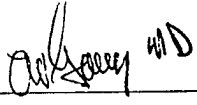

District Health Officer

Date Issued: 09/28/2000

Renewed 9/19/01 Rec # 024830

**PERMIT INSTRUCTIONS**

STRUCTURE TYPE: **Single Family Residence**

NUMBER OF BEDROOMS: **3**

DESIGN FLOW (gal/day): **360**

TYPE OF SYSTEM: **New**

SYSTEM DESIGN: **Conv. Pressure Distribution**

SEPTIC TANK CAPACITY (gal): **1000**

REASON SYSTEM DESIGN: **Shallow seasonal water and rest**

DFLF/BED DIMENSIONS: **300'**

TRENCH DEPTH (inches): **12**

TRENCH WIDTH (inches): **36**

APPURTANENCES: **\* see below**

PUMP CHAMBER (y/n): **Y**

PUMP CHAMBER GALLONS: **500**

SPECIAL PERMIT INSTRUCTIONS: **12" maximum trench depth in original soil. \*Cleanout and Observation ports**

FINAL INSPECTION DATE: 11, 27, 02

INITIALS: Lori Walk


\*\* SEE REVERSE FOR AS BUILT DRAWING

- |                              |              |                    |                |
|------------------------------|--------------|--------------------|----------------|
| * Stevens County Office      | P.O. Box 270 | Colville, WA 99114 | (509) 684-2262 |
| * Pend Oreille County Office | P.O. Box 490 | Newport, WA 99156  | (509) 447-3131 |
| * Ferry County Office        | P.O. Box 584 | Republic, WA 99166 | (509) 775-3111 |

324982

FINAL AS-BUILT DRAWING - PERMIT # 5000924

DATE OF FINAL INSPECTION 11/27/02 BY Leri Welk

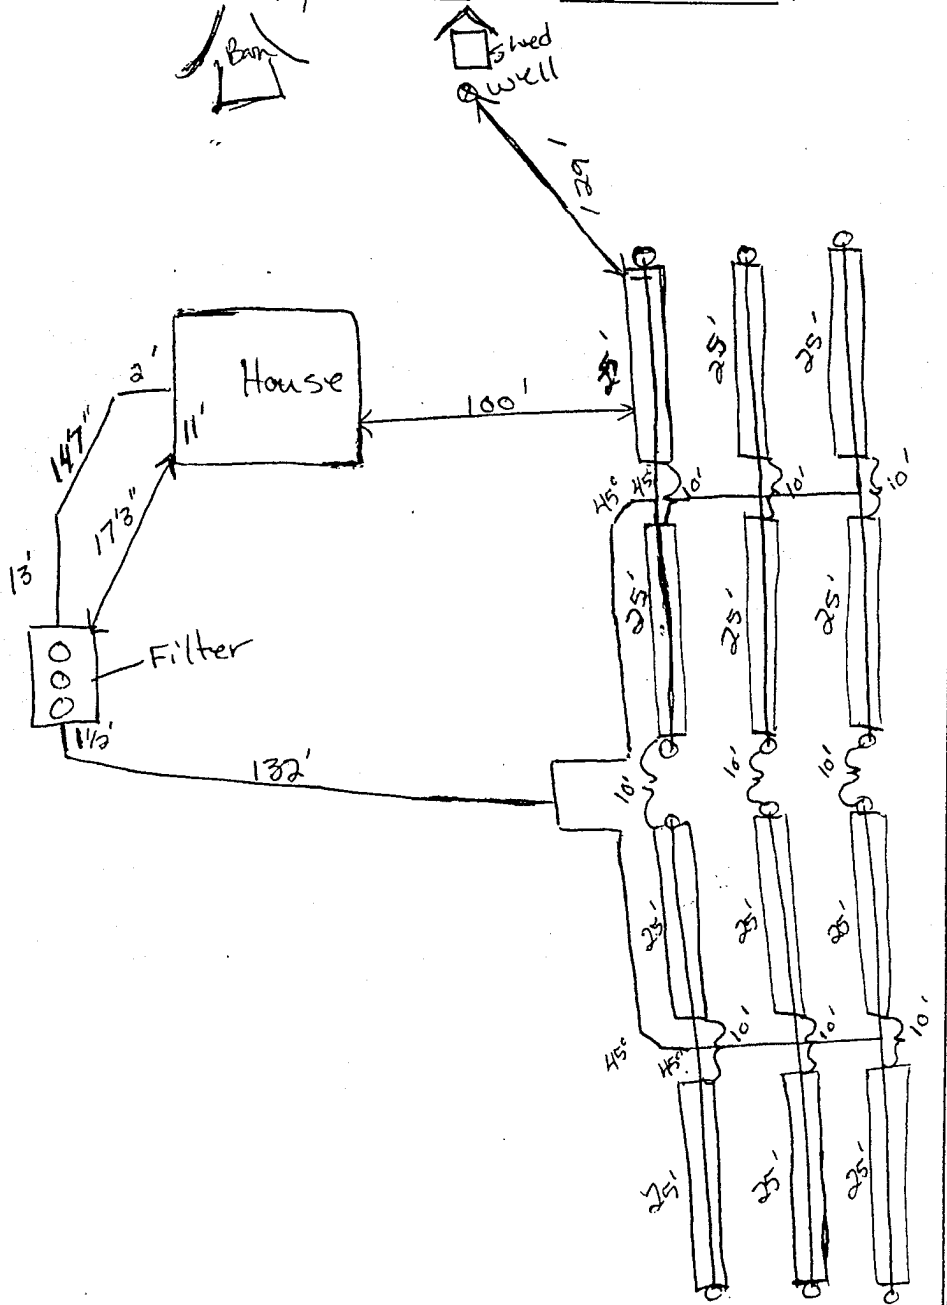

Contractor: Vance Durpos  
1 1/2 inch draw down  
(weep hole + drain back decreases draw down)