

SK 7698 ✓

**NORTHEAST TRI COUNTY HEALTH DISTRICT
DIVISION OF ENVIRONMENTAL HEALTH
ON-SITE SEWAGE SYSTEM PERMIT # 5002212**

5002212
13-32-40

Daniel & Shirley Lenard is hereby authorized to utilize a sewage disposal system at
LESS S 2200' W OF RD #2012 SW4; LESS S 2200' W RD #2012 W2 W2 SE4


Section: 31 Township: 32 Range: 40 Parcel #: 2614600

in accordance with the plans and specifications approved by the District Health Officer on file in this office.

Prior to any major repairs, replacements or alterations to the system a permit shall be obtained from the Northeast Tri County Health District (Division of Environmental Health).

This permit is issued and may be revoked by the Northeast Tri County Health District Health Officer by authority of WAC 246-272, and Northeast Tri County Health District Regulations established by the Board of Health pursuant to RCW 70.05.

Additional permits from other jurisdictions or agencies may be necessary for this project. It is the responsibility of the applicant to acquire said permit (s), and comply with all applicable rules, regulations and/or ordinances.

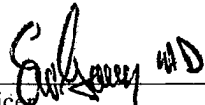

District Health Officer

Date Issued: 05/09/2005

PERMIT INSTRUCTIONS

STRUCTURE TYPE: **Single Family Residence**
NUMBER OF BEDROOMS: **2**
DESIGN FLOW (gal/day): **240**
TYPE OF SYSTEM: **New**
SYSTEM DESIGN: **Conventional Gravity**
SEPTIC TANK CAPACITY (gal): **1000**
REASON SYSTEM DESIGN:

DFLF/BED DIMENSIONS: **150'**
TRENCH DEPTH (inches): **15**
TRENCH WIDTH (inches): **36**
APPURTANENCES:
PUMP CHAMBER (y/n): **N**
PUMP CHAMBER GALLONS: **0**

SPECIAL PERMIT INSTRUCTIONS:

FINAL INSPECTION DATE: 5 / 27 / 05


INITIALS: BH

**** SEE REVERSE FOR AS BUILT DRAWING**

- | | | | |
|------------------------------|--------------|--------------------|----------------|
| * Stevens County Office | P.O. Box 270 | Colville, WA 99114 | (509) 684-2262 |
| * Pend Oreille County Office | P.O. Box 490 | Newport, WA 99156 | (509) 447-3131 |
| * Ferry County Office | P.O. Box 584 | Republic, WA 99166 | (509) 775-3111 |

NORTHEAST TRI COUNTY HEALTH DISTRICT
AS-BUILT DRAWING - PERMIT # 5002212

INSPECTION DATE 5/27/05 INSPECTED BY BH APPROVED: YES NO

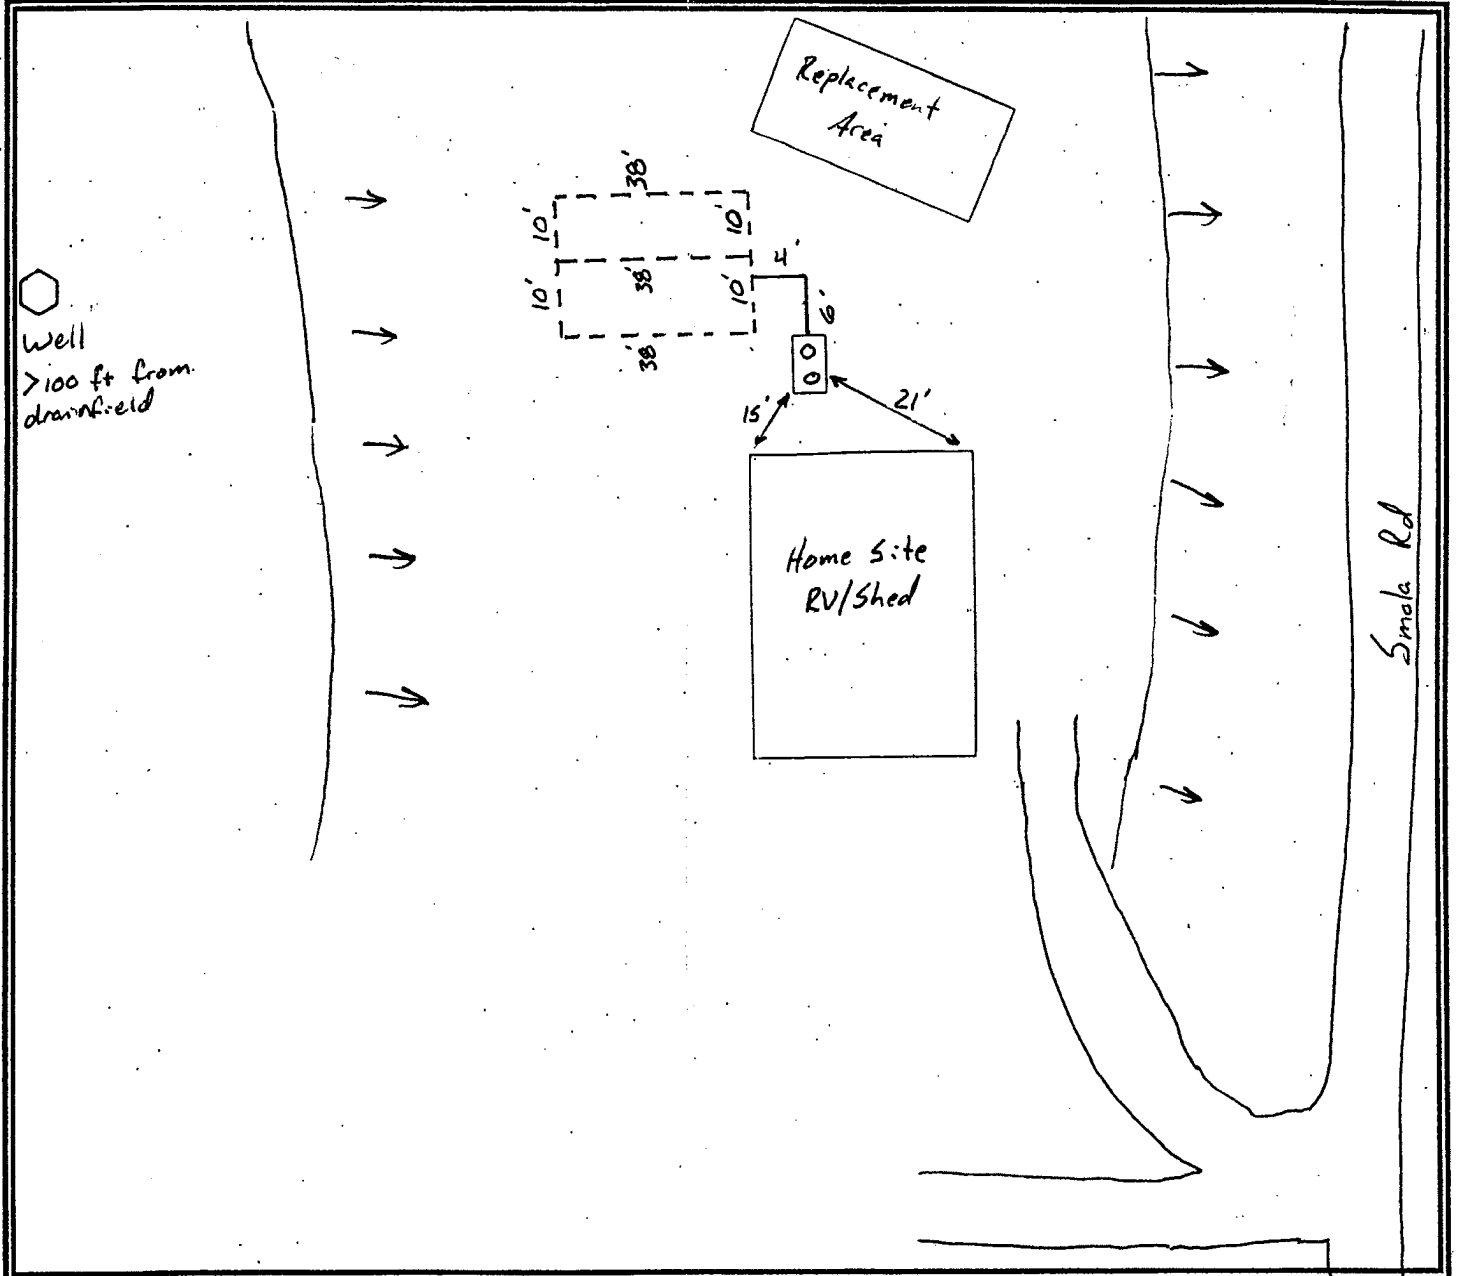

Installer Name Dale Bundy
 Septic Tank Size 1000
 Drainfield Length 154'
 Drainfield Depth 15"

Pump Chamber Size _____
 Doses/Day _____ Gallons/Dose _____
 Squirt Height _____ Drawdown _____
 Pump Run Time _____