

**NORTHEAST TRI COUNTY HEALTH DISTRICT  
DIVISION OF ENVIRONMENTAL HEALTH**

**ON-SITE SEWAGE SYSTEM PERMIT # PT0008226**

Arbor Farms LLC is hereby authorized to utilize a sewage disposal system at  
N OF RD NE4 NE4, LS M/R & N OF RD NW4 NE4, LS 51% M/R & LS W 45 RODS

Section: 11      Township: 35      Range: 37      Parcel #: 1684600

in accordance with the plans and specifications approved by the District Health Officer on file in this office.

Prior to any major repairs, replacements or alterations to the system a permit shall be obtained from the NorthEast Tri County Health District (Division of Environmental Health).

This permit is issued and may be revoked by the NorthEast Tri County Health District Health Officer by authority of WAC 246-272, and Northeast Tri County Health District Regulations established by the Board of Health pursuant to RCW 70.05.

Additional permits from other jurisdictions or agencies may be necessary for this project. It is the responsibility of the applicant to acquire said permit(s), and comply with all applicable rules, regulations and/or ordinances.

Date Issued: 05/20/2008



District Health Officer

**PERMIT INSTRUCTIONS**

**STRUCTURE TYPE:** Single-Family Residential

**NUMBER OF BEDROOMS:** 3

**DESIGN FLOW (gal/day):** 360

**TYPE OF SYSTEM:** New

**SYSTEM DESIGN:** Gravity w/ Gravelless Cha

**SEPTIC TANK CAPACITY (gal):** 1000

**DFLF/BED DIMENSIONS:**36

**TRENCH DEPTH (inches):** 12

**TENCH WIDTH (inches):**

**APPURTANENCES:** Distribution Box

**PUMP CHAMBER (y/n):** N

**PUMP CHAMBER GALLONS:**

**REASON SYSTEM DESIGN:**

**SPECIAL PERMIT INSTRUCTIONS:** 15% reduction from 300' for use of gravelless chambers.

**FINAL INSPECTION DATE:** 07/31/08

**Initials:** DE

**\*\* SEE REVERSE FOR AS BUILT DRAWING**

Stevens County Office

Pend Oreille County Office

Ferry County Office

P.O.Box 270

P.O. Box 490

P.O. Box 584

Colville,

Newport,

Republic,

WA

WA

WA

99114

99156

99166


(509) 684-2262

(509) 447-3131

(509) 775-3111

NORTHEAST TRI COUNTY HEALTH DISTRICT  
 AS-BUILT DRAWING - PERMIT # PT0008226

INSPECTION DATE 07/31/08 INSPECTED BY DE APPROVED:  YES  NO

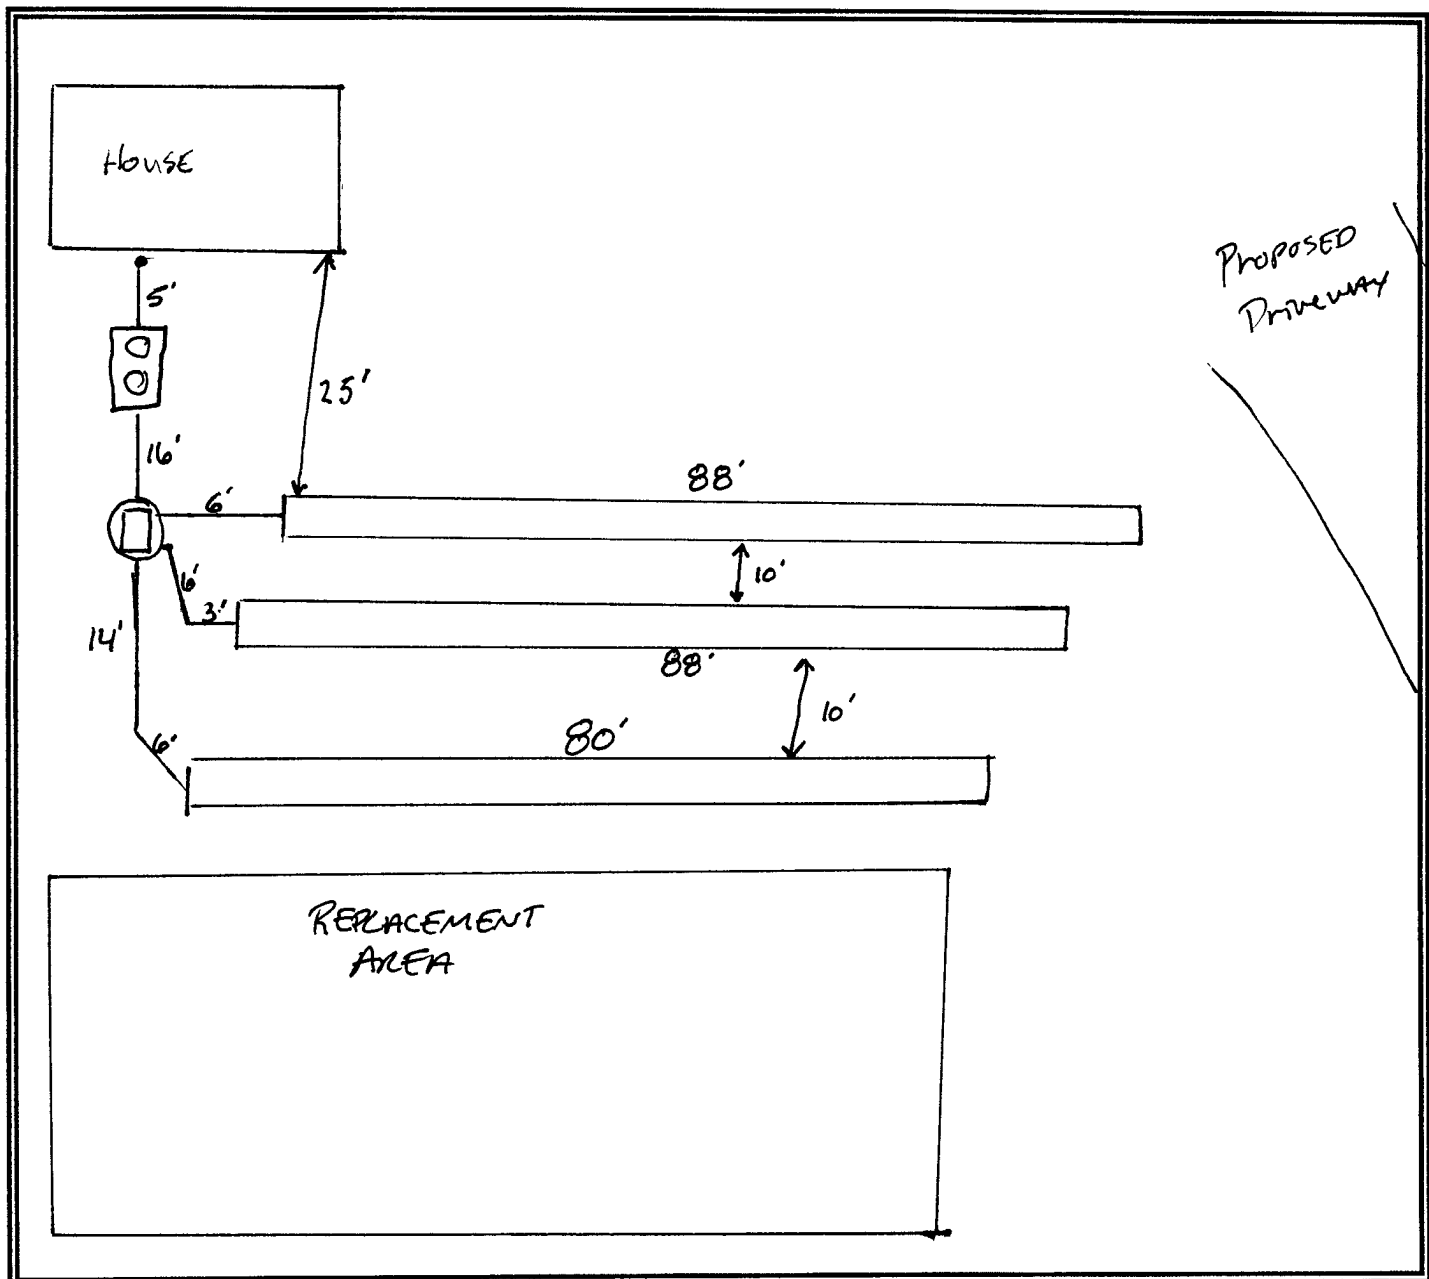

Installer Name ANDY MATTHEWS  
 Septic Tank Size 1000  
 Drainfield Length 256'  
 Drainfield Depth 24'

Pump Chamber Size \_\_\_\_\_  
 Doses/Day \_\_\_\_\_ Gallons/Dose \_\_\_\_\_  
 Squirt Height \_\_\_\_\_ Drawdown \_\_\_\_\_  
 Pump Run Time \_\_\_\_\_