

SR 12740

NORTHEAST TRI COUNTY HEALTH DISTRICT
DIVISION OF ENVIRONMENTAL HEALTH

ON-SITE SEWAGE SYSTEM PERMIT # PT0012943

Duffield Family Trust is hereby authorized to utilize a sewage disposal system at
Kettle Falls Central 2 Block: 11 & 12 Lot: 69

Section: 23 Township: 36 Range: 37 Parcel #: 307573

in accordance with the plans and specifications approved by the District Health Officer on file in this office.

Prior to any major repairs, replacements or alterations to the system a permit shall be obtained from the NorthEast Tri
County Health District (Division of Environmental Health).

This permit is issued and may be revoked by the NorthEast Tri County Health District Health Officer by authority of
WAC 246-272, and Northeast Tri County Health District Regulations established by the Board of Health pursuant to
RCW 70.05.

Additional permits from other jurisdictions or agencies may be necessary for this project. It is the responsibility of the
applicant to acquire said permit(s), and comply with all applicable rules, regulations and/or ordinances.

Date Issued: 07/06/2010



District Health Officer

PERMIT INSTRUCTIONS

STRUCTURE TYPE: Single-Family Residential

DFLF/BED DIMENSIONS: 152

NUMBER OF BEDROOMS: 3

TRENCH DEPTH (inches): 36

DESIGN FLOW (gal/day): 360

TENCH WIDTH (inches): 36

TYPE OF SYSTEM: New

APPURTANENCES: D Box & Effluent Filter

SYSTEM DESIGN: Gravity w/ Gravelless Chambers

PUMP CHAMBER (y/n):

SEPTIC TANK CAPACITY (gal): 1000

PUMP CHAMBER GALLONS:

REASON SYSTEM DESIGN:

SPECIAL PERMIT INSTRUCTIONS: 25% reduction from 200' of drainfield for use of gravelless chambers.

FINAL INSPECTION DATE: 07/23/10

Initials: DE


** SEE REVERSE FOR AS BUILT DRAWING

Stevens County Office	260 S. Oak	Colville, WA	99114	(509) 684-2262
Pend Oreille County Office	605 Hwy 20	Newport, WA	99156	(509) 447-3131
Ferry County Office	P.O. Box 584	Republic, WA	99166	(509) 775-3111

SR 12740

NORTHEAST TRI COUNTY HEALTH DISTRICT
AS-BUILT DRAWING - PERMIT # PT0012943

INSPECTION DATE 07/23/10 INSPECTED BY DE APPROVED: YES NO

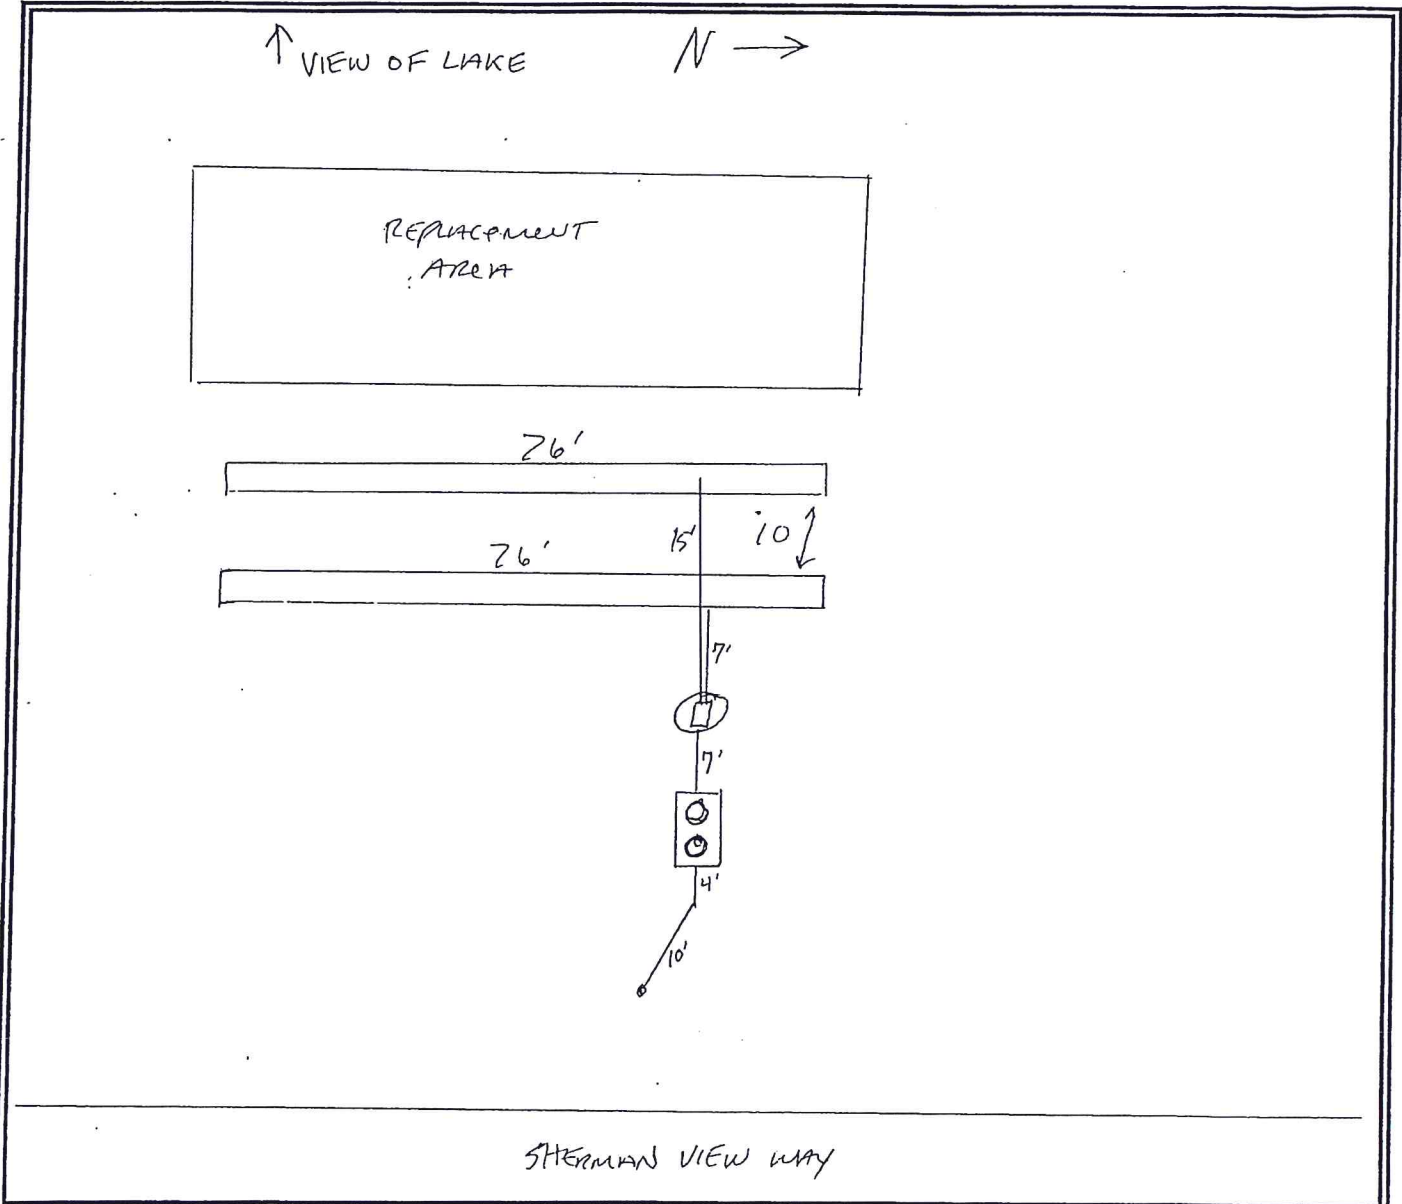

Installer Name JAMES MALLER Y
Septic Tank Size 1000 GALLONS
Drainfield Length 152'
Drainfield Depth 36"

Pump Chamber Size _____
Doses/Day _____ Gallons/Dose _____
Squirt Height _____ Drawdown _____
Pump Run Time _____