

Septic Tank	<u>1000</u>	Gals.
Disp. Field	<u>200</u>	L.F.T.
Other	_____	
<input checked="" type="checkbox"/> New	_____	
<input type="checkbox"/> Repair	_____	

**NORTHEAST TRI-COUNTY HEALTH DISTRICT**  
**Division of Environmental Health**  
 Colville Office, Box 270, Phone 684-2262  
 Newport Office, Box 490, Phone 447-3131  
 Republic Office, Box 584, Phone 775-3161

Permit No. 9269  
 Fee Paid \$150.00  
 Receipt No. 7658

Vern & Lynette White is hereby authorized to utilize a sewage disposal

system at Sec. 16, Twp. 35, Rge. 37 (7-35-16-50-00110-00) Lot 11 Mertig Cr. Tree Farms and in accordance with the plans and specifications approved by the District Health Officer on file in this office.

Any major repairs or alterations to the system shall be reported to the Northeast Tri-County Health District (Division of Environmental Health) for approval PRIOR to construction.

This permit is issued and may be revoked by the Northeast Tri-County Health District Health Officer by the authority of WAC 246-272, and Rules and Regulations established by the Board pursuant to RCW 70.05.

Witness my hand and seal this 2nd day of November, 19 94

Date of Inspection 10/12/95  
 District Health Officer [Signature]  
 HEALTHY ACCEPTED

Lot 11  
Mertig Creek Tree Farms  
16-33-31

# Northeast Tri County Health District Sewage Permit Record Search Request

The Health District has sewage permit records on file. The sewage permit records contain information about a sewage system, such as permit number, as-built drawing of installed system, septic tank sizing, drainfield location and dimensions, etc. Information from the sewage permit is useful when locating the septic tank for pumping, when determining locations for outbuildings and driveways, or when property ownership changes.

To request sewage permit information, please complete this form. If a permit is on record with the Health District, you will be provided a copy of the sewage permit and as-built drawing of the sewage system.

Request Made By (Name)	<u>Sherry Spencer</u>	Date	<u>6/27/07</u>		
Address	<u>327 S. Main</u>	City/State	<u>Colville</u>	Zip Code	<u>99114</u>
Phone #	<u>684-1000</u>	FAX #	<u>684-5660</u>		

The information in this box must be complete or a copy of a tax statement or assessors record must be provided.

Name of Property Owner Peterson, Chad

Legal Description of Property (rural description or subdivision, lot & block number)  
Lot 11 Martin Creek

Section 17 Township 35 Range 37 Parcel # 73517500011000

Please provide as much of the following information as possible. This information is helpful for locating sewage permits when property ownership has changed or the property has been subdivided.

Ownership History (provide names of previous property owners)

Matney → White → Turner → Peterson

Sewage Permit # \_\_\_\_\_ Date Sewage System Installed \_\_\_\_\_

Type & Age of Structure \_\_\_\_\_

Has property been subdivided?  Yes  No (if yes, when \_\_\_\_\_, plat name or # \_\_\_\_\_)

If you have any questions or need additional information, please contact the Environmental Health office.

Colville: 1-509-684-2262

Newport: 1-509-447-3131

Republic: 1-509-775-3111

1-800-776-6207

1-800-873-6162

1-800-876-3319

FAX: 1-509-684-8506

FAX: 1-509-447-5644

FAX: 1-509-775-2858

\*\*\*\* For Office Use Only \*\*\*\*

Based on the information provided above:

Sewage permit # 9269 was located in the records. A copy of the permit and as-built drawing are attached.  
The sewage system was sized to serve a 3 bedroom residential

No record of a sewage permit was found.

Other: \_\_\_\_\_


By Pelino

Date 6/27/07

Les Iverson  
2776 Farm to Market Rd.  
Chewelah, WA 99109

Nov. 13, 1994

*For: Vern White - Martin Creek*  
← to Inchelium

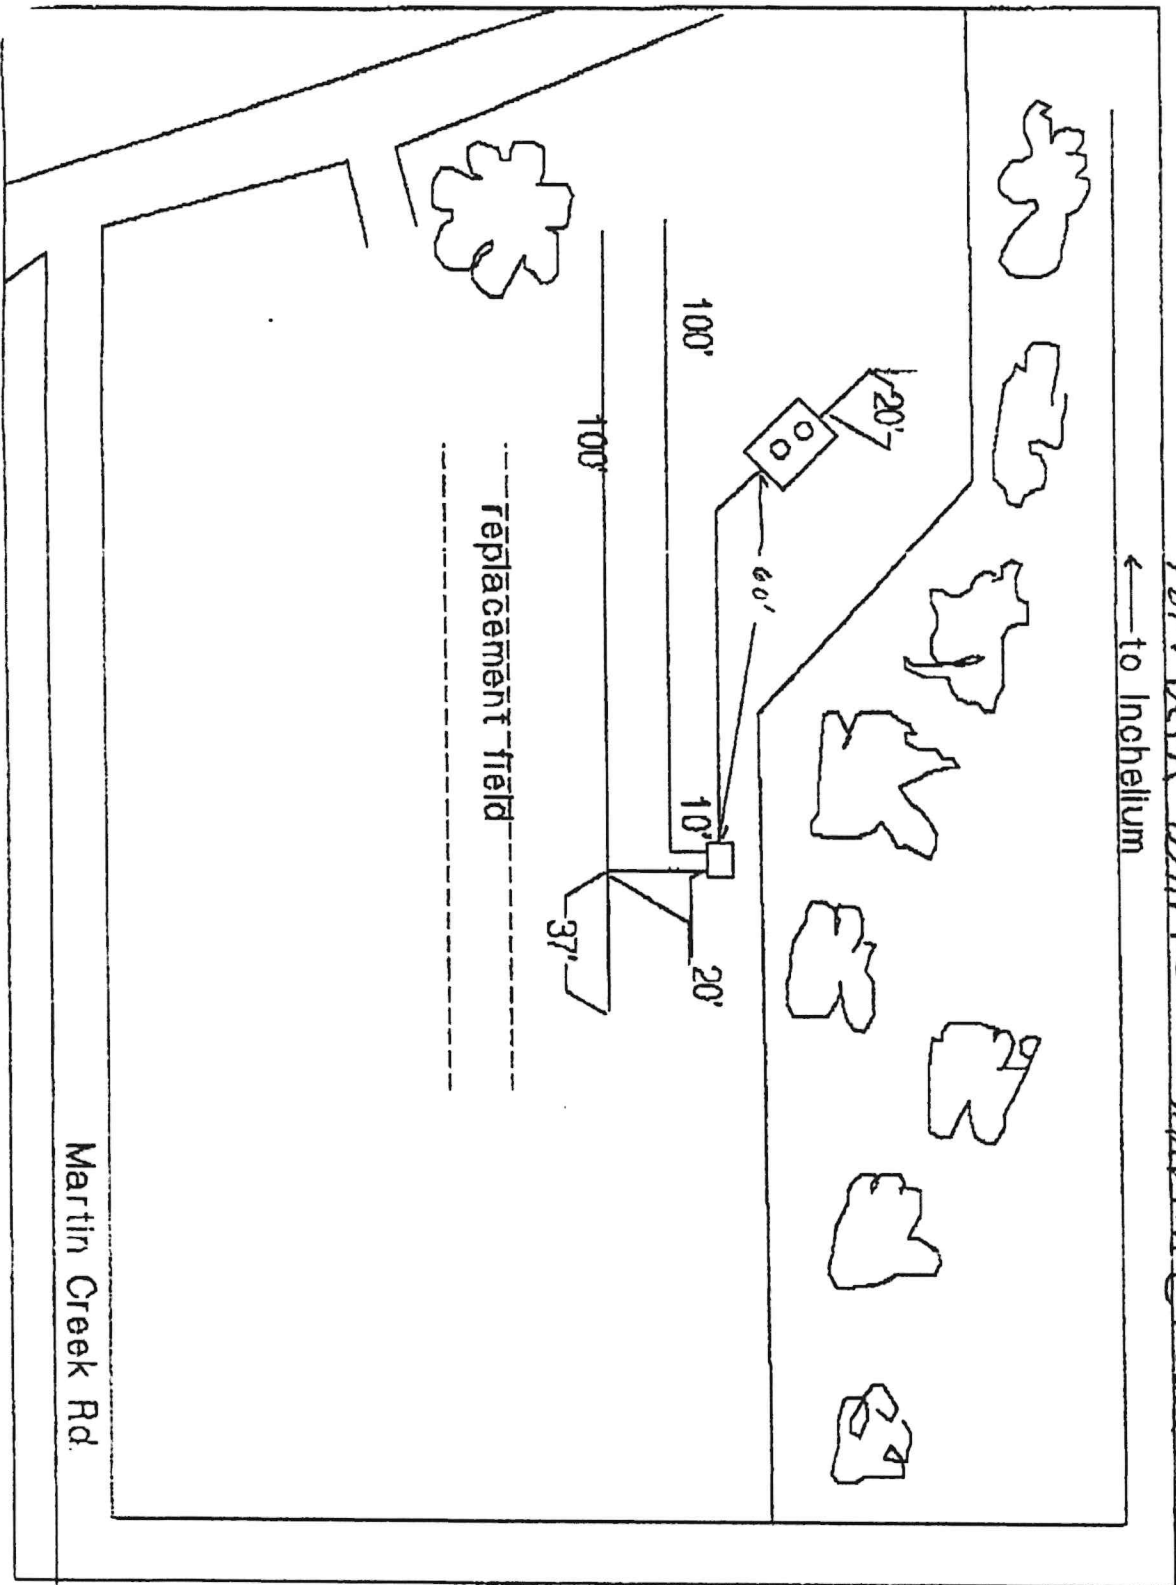

RECEIVED

JAN 11 1995

