

NORTHEAST TRI COUNTY HEALTH DISTRICT
DIVISION OF ENVIRONMENTAL HEALTH

ON-SITE SEWAGE SYSTEM PERMIT # PT0012550

Matney Lumber Co Inc is hereby authorized to utilize a sewage disposal system at
Dolomite Lot: 15

Section: 13 Township: 35 Range: 39 Parcel #: 874217

in accordance with the plans and specifications approved by the District Health Officer on file in this office.

Prior to any major repairs, replacements or alterations to the system a permit shall be obtained from the NorthEast Tri
County Health District (Division of Environmental Health).

This permit is issued and may be revoked by the NorthEast Tri County Health District Health Officer by authority of
WAC 246-272, and Northeast Tri County Health District Regulations established by the Board of Health pursuant to
RCW 70.05.

Additional permits from other jurisdictions or agencies may be necessary for this project. It is the responsibility of the
applicant to acquire said permit(s), and comply with all applicable rules, regulations and/or ordinances.

Date Issued: 05/11/2010



District Health Officer

PERMIT INSTRUCTIONS

STRUCTURE TYPE: Single-Family Residential

DFLF/BED DIMENSIONS:400

NUMBER OF BEDROOMS: 2

TRENCH DEPTH (inches): 24

DESIGN FLOW (gal/day): 240

TENCH WIDTH (inches): 36

TYPE OF SYSTEM: New

APPURTANENCES: D Box & Effluent Filter

SYSTEM DESIGN: Gravity w/ Gravelless Chambers

PUMP CHAMBER (y/n): N

SEPTIC TANK CAPACITY (gal): 1000

PUMP CHAMBER GALLONS:

REASON SYSTEM DESIGN:

SPECIAL PERMIT INSTRUCTIONS:

FINAL INSPECTION DATE: 05/20/10


Initials: DE

** SEE REVERSE FOR AS BUILT DRAWING

Stevens County Office	260 S. Oak	Colville, WA	99114	(509) 684-2262
Pend Oreille County Office	605 Hwy 20	Newport, WA	99156	(509) 447-3131
Ferry County Office	P.O. Box 584	Republic, WA	99166	(509) 775-3111

NORTHEAST TRI COUNTY HEALTH DISTRICT
 AS-BUILT DRAWING - PERMIT # PT0012550

INSPECTION DATE 05/20/10 INSPECTED BY DE APPROVED: YES NO

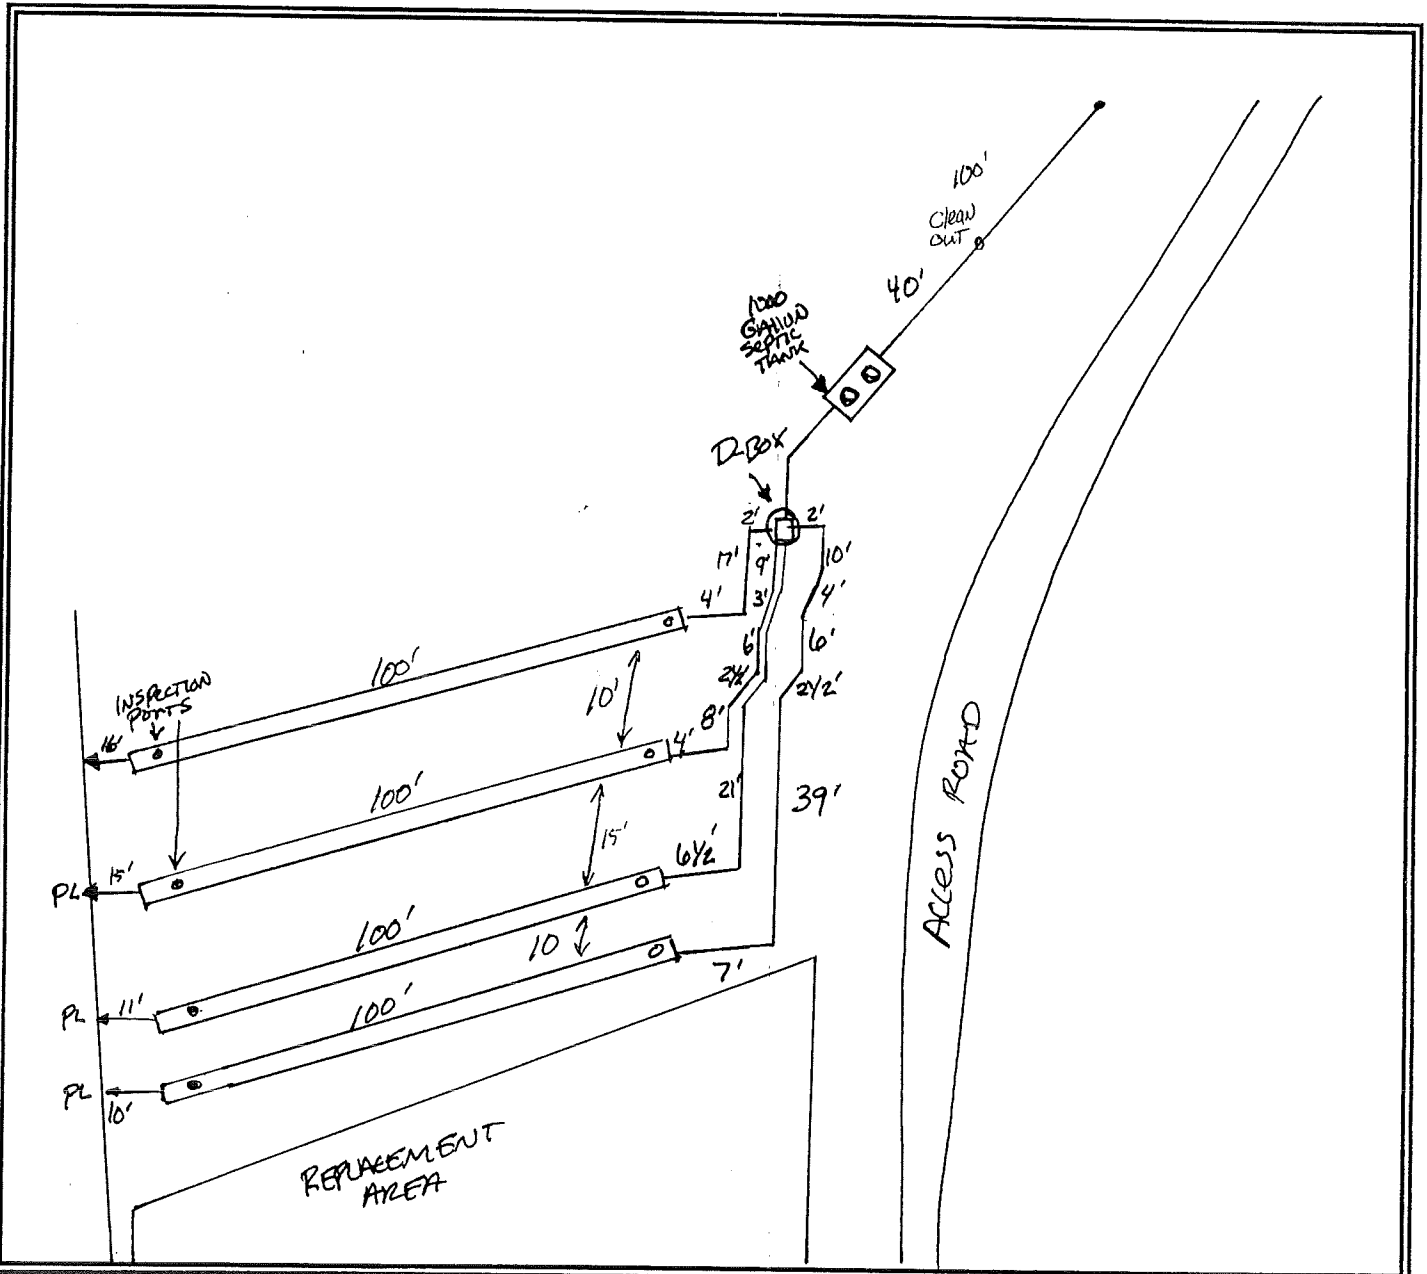

Installer Name MARK STRAUB
 Septic Tank Size 1000 GALLONS
 Drainfield Length 400'
 Drainfield Depth 24"

Pump Chamber Size _____
 Doses/Day _____ Gallons/Dose _____
 Squirt Height _____ Drawdown _____
 Pump Run Time _____

(Revised 7/2003)