

210210

Septic Tank 1000 Gals.
 Disp. Field 300 L.F.T
 Other 2 boxes
 New
 Repair

NORTHEAST TRI-COUNTY HEALTH DISTRICT
Division of Environmental Health

- Colville Office, Box 270, Phone 684-2262
- Newport Office, Box 490, Phone 447-3131
- Republic Office, Box 584, Phone 775-3161

Permit No. 0338

Fee Paid \$150.00

Receipt No. 0865

*check 1/2 box for water level after 1 yr of operation.
 check along 2 yrs after.*

Roger Lawson is hereby authorized to utilize a sewage disposal

system at Less Tax 10-11, NB. Rd. 1/2 NB NW 1/4
Sec. 26, Twp. 35, Rge. 39 and in accordance
 with the plans and specifications approved by the District Health Officer on file in this office.

Any major repairs or alterations to the system shall be reported to the Northeast Tri-County Health District (Division of Environmental Health) for approval PRIOR to construction.

This permit is issued and may be revoked by the Northeast Tri-County Health District Health Officer by the authority of WAC 248-96, and Rules and Regulations established by the Board pursuant to RCW 70.05.





Witness my hand and seal this 23rd day of July, 19 81

Date of Inspection 2-11-81
[Signature]
 District Health Officer

checked 26-35-39

12-11-91
W. Smith
EJM

SK3413

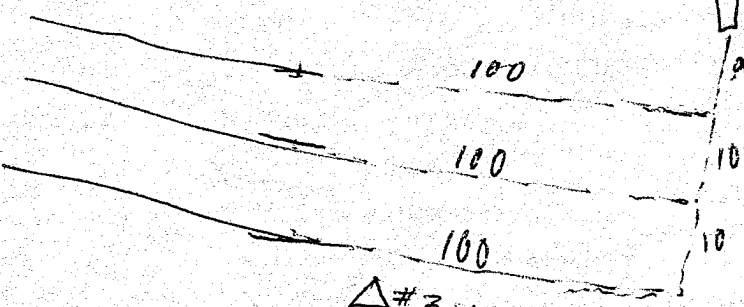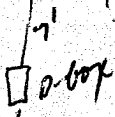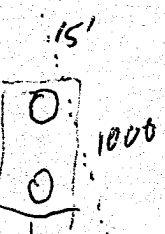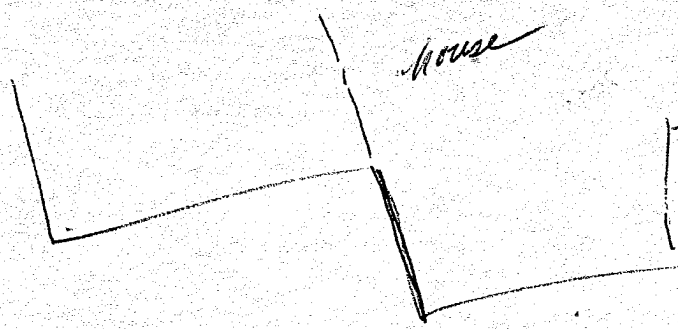

Δ#3 12-11-91

Third test hole dug to confirm lack of restrictive layer since 2/8 installed closer to swale than indicated on plat plan.

Δ#2

Δ#1