

**NORTHEAST TRI COUNTY HEALTH DISTRICT  
DIVISION OF ENVIRONMENTAL HEALTH  
ON-SITE SEWAGE SYSTEM PERMIT # 5000787**

Lester & Barbara Selby is hereby authorized to utilize a sewage disposal system at Lot 4 of SP # 110-83

Section: 16 Township: 31 Range: 40 Parcel #: 2526225

in accordance with the plans and specifications approved by the District Health Officer on file in this office.

Prior to any major repairs, replacements or alterations to the system a permit shall be obtained from the Northeast Tri County Health District (Division of Environmental Health).

This permit is issued and may be revoked by the Northeast Tri County Health District Health Officer by authority of WAC 246-272, and Northeast Tri County Health District Regulations established by the Board of Health pursuant to RCW 70.05.

Additional permits from other jurisdictions or agencies may be necessary for this project. It is the responsibility of the applicant to acquire said permit (s), and comply with all applicable rules, regulations and/or ordinances.



\_\_\_\_\_  
District Health Officer

Date Issued: 05/25/2000

**PERMIT INSTRUCTIONS**

STRUCTURE TYPE: **Single Family Residence**  
NUMBER OF BEDROOMS: **2**  
DESIGN FLOW (gal/day): **240**  
TYPE OF SYSTEM: **New**  
SYSTEM DESIGN: **Conventional Gravity**  
SEPTIC TANK CAPACITY (gal): **1000**  
REASON SYSTEM DESIGN: **loam/sandy loam soils**

DFLF/BED DIMENSIONS: **200'**  
TRENCH DEPTH (inches): **18**  
TRENCH WIDTH (inches): **36**  
APPURTANENCES: **Distribution box**  
PUMP CHAMBER (y/n): **N**  
PUMP CHAMBER GALLONS: **0**

SPECIAL PERMIT INSTRUCTIONS: **Note that drainfield size is sufficient for a 3 bedroom home given the Type 4 soils (loam/sandy loam)**

FINAL INSPECTION DATE: 7 / 25 / 00

INITIALS:   *AS*  


**\*\* SEE REVERSE FOR AS BUILT DRAWING**

Page 2

* Stevens County Office	P.O. Box 270	Colville, WA 99114	(509) 684-2262
* Pend Oreille County Office	P.O. Box 490	Newport, WA 99156	(509) 447-3131
* Ferry County Office	P.O. Box 584	Republic, WA 99166	(509) 775-3111

FINAL AS-BUILT DRAWING - PERMIT # 5000787

DATE OF FINAL INSPECTION 7/25/00 BY DJ

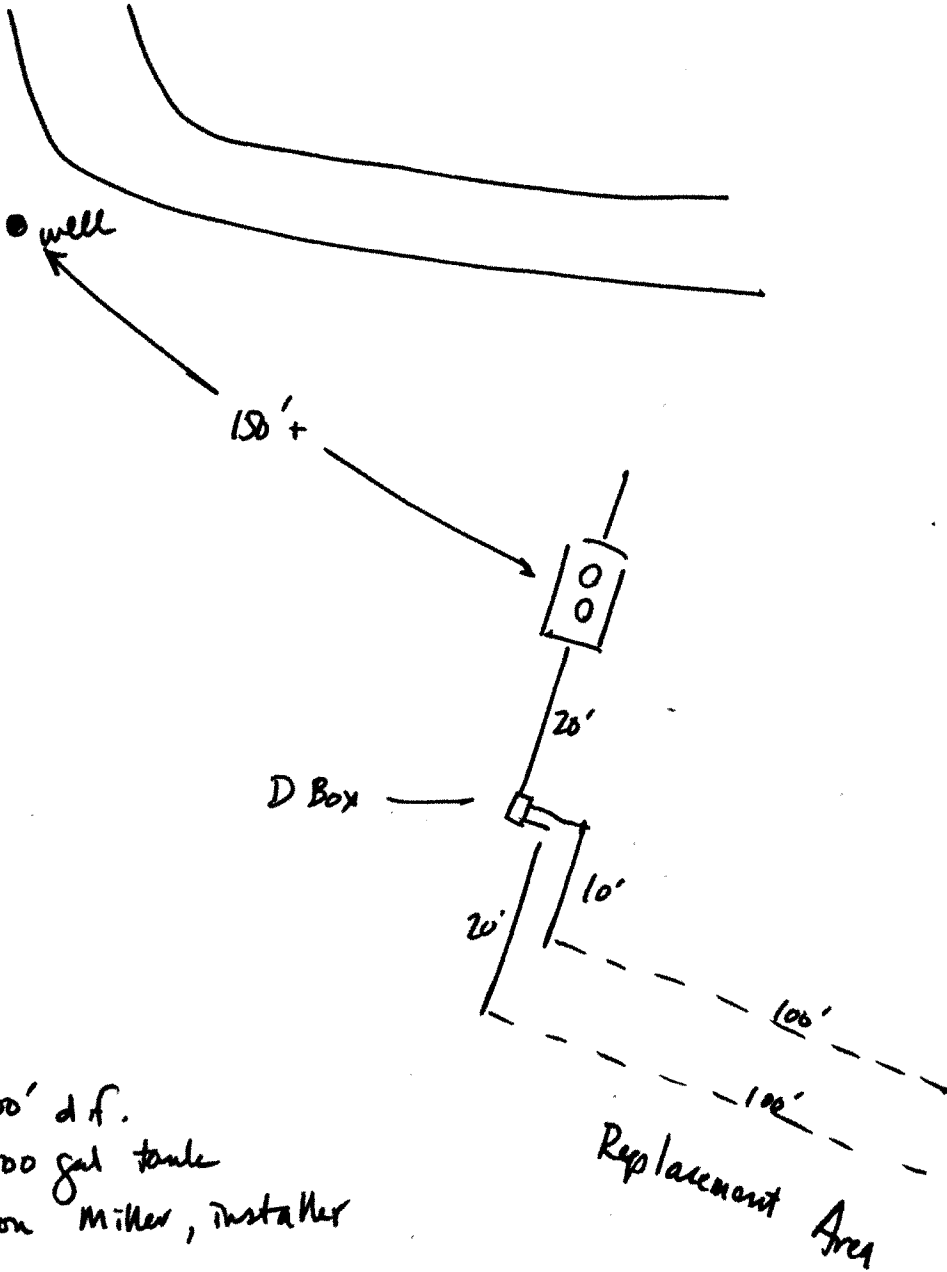

200' d.f.  
1000 gal tank  
Ron Miller, installer