

SR 2789

NORTHEAST TRI COUNTY HEALTH DISTRICT
DIVISION OF ENVIRONMENTAL HEALTH
ON-SITE SEWAGE SYSTEM PERMIT # 1000339

Lot 3
Horizon SP

2-37-32


Charles & Rosemary Inabnit is hereby authorized to utilize a sewage disposal system at
Lot 3 Horizon SP # 88-006
SUBDIVISION LOT 3
Section: 2 Township: 37 Range: 32 Parcel # 2-37-02-24-000-1300

in accordance with the plans and specifications approved by the District Health Officer on file in this office.

Prior to any major repairs, replacements or alterations to the system a permit shall be obtained from the Northeast Tri County Health District (Division of Environmental Health).

This permit is issued and may be revoked by the Northeast Tri County Health District Health Officer by authority of WAC 246-272, and Northeast Tri County Health District Regulations established by the Board of Health pursuant to RCW 70.05.

Additional permits from other jurisdictions or agencies may be necessary for this project. It is the responsibility of the applicant to acquire said permit (s), and comply with all applicable rules, regulations and/or ordinances.

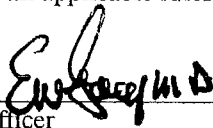

District Health Officer

Date Issued: 06/30/2003

PERMIT INSTRUCTIONS

STRUCTURE TYPE: **Single Family Residence**
NUMBER OF BEDROOMS: **3**
DESIGN FLOW (gal/day): **360**
TYPE OF SYSTEM: **New**
SYSTEM DESIGN: **Conventional Gravity**
SEPTIC TANK CAPACITY (gal): **1000**

DFLF/BED DIMENSIONS: **150**
TRENCH DEPTH (inches): **36**
TRENCH WIDTH (inches): **36**
APPURTANENCES: **D- Box**
PUMP CHAMBER (y/n): **N**
PUMP CHAMBER GALLONS: **0**

REASON SYSTEM DESIGN: **Gravelly fine sand.**

SPECIAL PERMIT INSTRUCTIONS:

FINAL INSPECTION DATE: 7 / 28 / 03


INITIALS: MA

** SEE REVERSE FOR AS BUILT DRAWING

FINAL AS-BUILT DRAWING - PERMIT # 1000339

DATE OF FINAL INSPECTION 7/28/03 BY MM

↑ TO TROUT CREEK RD.

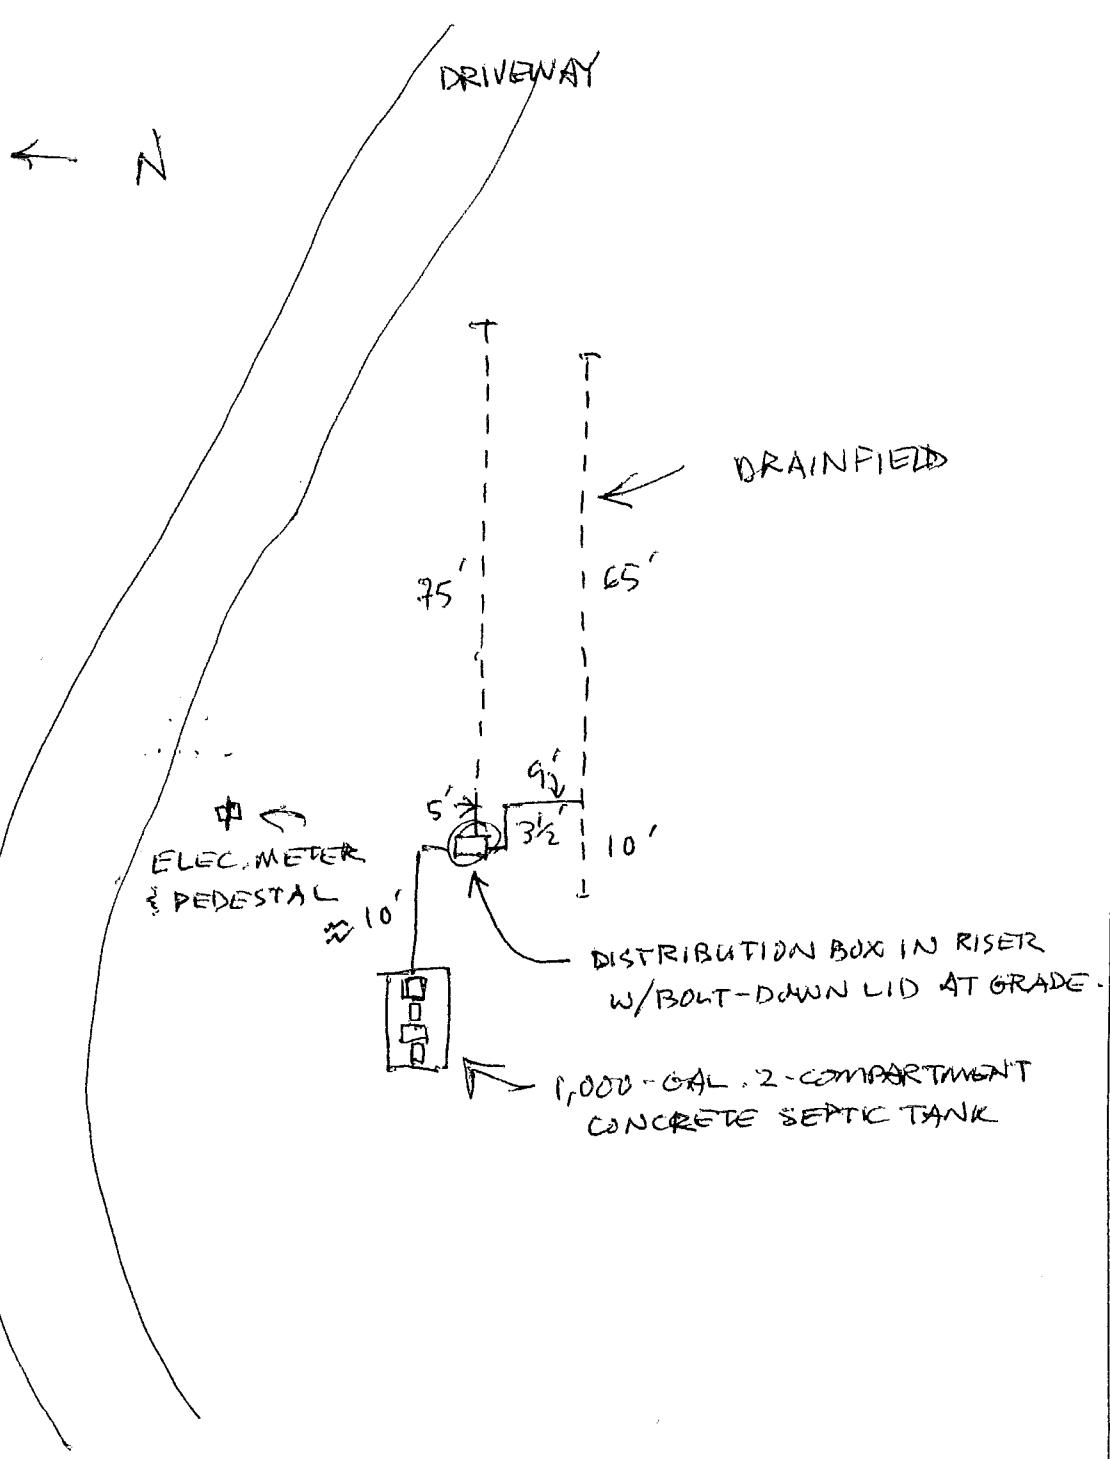

DESIGNED & INSTALLED BY MIKE FAGLEY

(REVISED 2/98)