

0N0015028

NORTHEAST TRI COUNTY HEALTH DISTRICT
DIVISION OF ENVIRONMENTAL HEALTH

ON-SITE SEWAGE SYSTEM PERMIT # PT0016671

Don Andresen is hereby authorized to utilize a sewage disposal system at
N2 NE4 SW4

Section: 15 Township: 29 Range: 36 Parcel #: 1514865

in accordance with the plans and specifications approved by the District Health Officer on file in this office.

Prior to any major repairs, replacements or alterations to the system a permit shall be obtained from the NorthEast Tri County Health District (Division of Environmental Health).

This permit is issued and may be revoked by the NorthEast Tri County Health District Health Officer by authority of WAC 246-272, and Northeast Tri County Health District Regulations established by the Board of Health pursuant to RCW 70.05.

Additional permits from other jurisdictions or agencies may be necessary for this project. It is the responsibility of the applicant to acquire said permit(s), and comply with all applicable rules, regulations and/or ordinances.

Date Issued: 06/18/2013



District Health Officer

PERMIT INSTRUCTIONS

STRUCTURE TYPE: Single-Family Residential

DFLF/BED DIMENSIONS: 204

NUMBER OF BEDROOMS: 3

TRENCH DEPTH (inches): 36

DESIGN FLOW (gal/day): 360

TENCH WIDTH (inches): 36

TYPE OF SYSTEM: New

APPURTANENCES: Distribution Box

SYSTEM DESIGN: Gravity w/ Gravelless Chambers

PUMP CHAMBER (y/n):

SEPTIC TANK CAPACITY (gal): 1000

PUMP CHAMBER GALLONS:

REASON SYSTEM DESIGN: Type 1 exemption

SPECIAL PERMIT INSTRUCTIONS: No reduction for using gravelless chambers

FINAL INSPECTION DATE: 6/2/2015


Initials: MS

| | | | | | |
|----------------------------|----------------|-----------|----|-------|----------------|
| Stevens County Office | 240 E Dominion | Colville, | WA | 99114 | (509) 684-2262 |
| Pend Oreille County Office | 605 Hwy 20 | Newport, | WA | 99156 | (509) 447-3131 |
| Ferry County Office | P.O. Box 584 | Republic, | WA | 99166 | (509) 775-3111 |



On-Site Sewage System As-Built Drawing for Permit # PT0016671

| | | | | |
|-----------------|--------|--|--------------------|--------|
| Inspection Date | 6/2/15 | Approved <input checked="" type="checkbox"/> Yes <input type="checkbox"/> No | Approved Date | 6/2/15 |
| Inspection By | MS | | Re-Inspection Date | — |

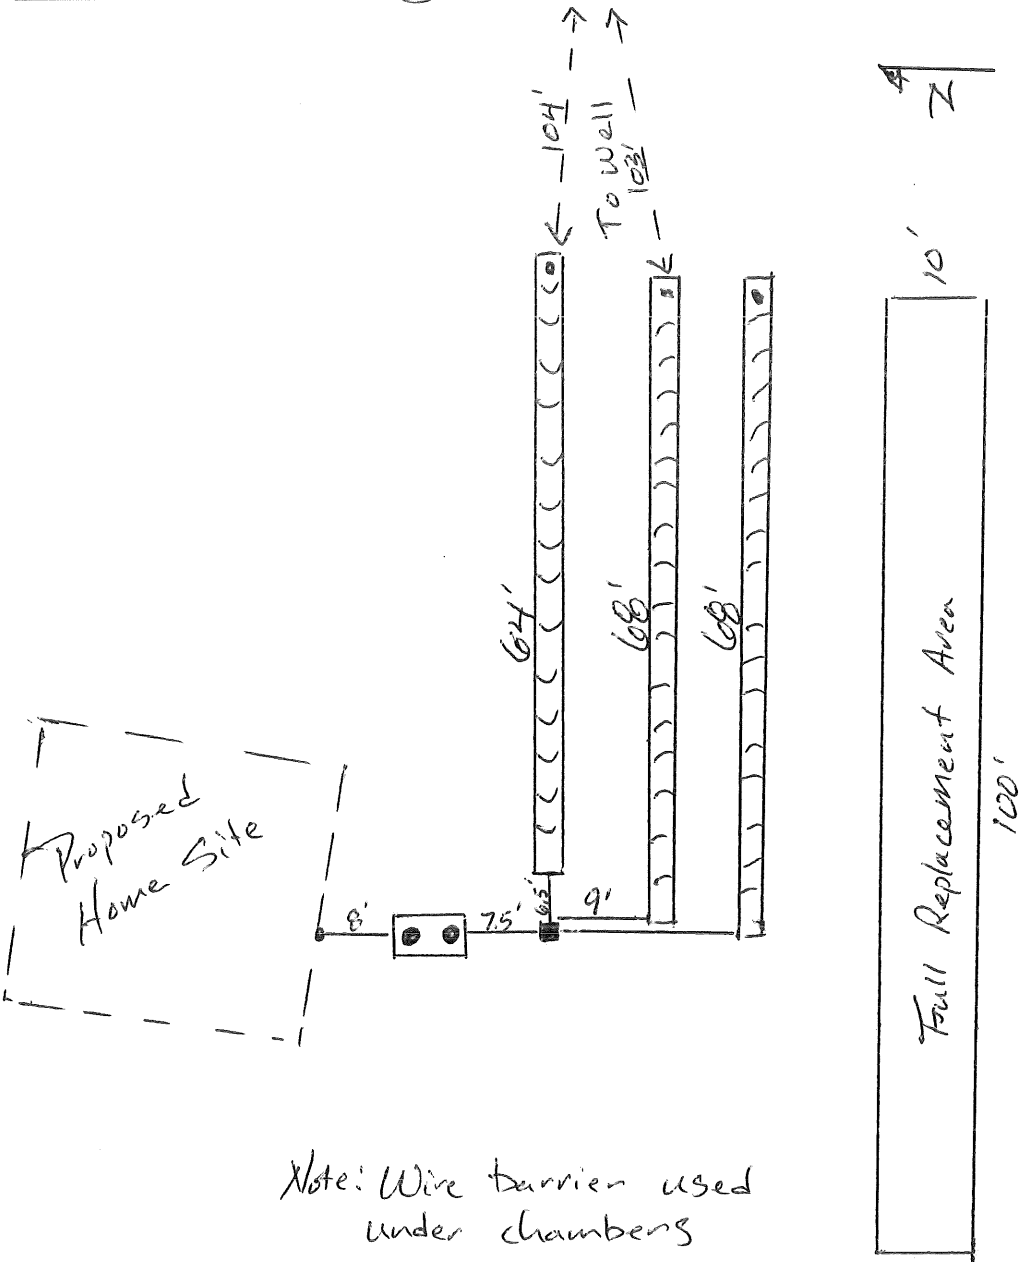

Note: Wire barrier used under chambers

| | | | | |
|--------------------------------|-------------------------|---------------|-------------------|--------------|
| Installer Name | Andy Matthews | | Pump Chamber Size | |
| Septic Tank Size | 1000 | Dose/day | | Gallons/Dose |
| Drainfield Length | 200' | Squirt Height | | Drawdown |
| Drainfield Depth | 36" | Pump Run Time | | |
| Septic Tank Latitude/Longitude | 48.012779 / -118.273919 | | | |