

SR 13503

COPY

1

Septic Tank	200	Gals.
Disp. Field	180'	L.F.T.
Other		

STEVENS COUNTY HEALTH DEPARTMENT

DIVISION OF ENVIRONMENTAL HEALTH

P.O. BOX 191

COLVILLE, WASHINGTON 99114

684-2262

Permit No. 388

\$10.00 FHA Rec# 6360

Fee Paid \$5.00 Rec# 6449

388

Ronnie Bodvin

is hereby authorized to utilize a sewage disposal

system at Tax # 283, Sec. 2530, Twp 31, Rge. 41 and in accordance with the plans and specifications approved by the County Health Officer, Stevens County Health Department, on file in this office.

Any major repairs or alterations to the system shall be reported to the Stevens County Health Department (Division of Environmental Health) for approval PRIOR to construction.


This permit is issued by the authority of the County Commissioners of Stevens County, Washington, and in accordance with the Stevens County Sanitary Code concerning sanitary regulations, passed by said Commissioners on the 13th of June, 1966.

Witness my hand and seal this 27 day of October, 1975

Date of Inspection 7-25 M.C.

County Health Officer, Stevens County

Form 941

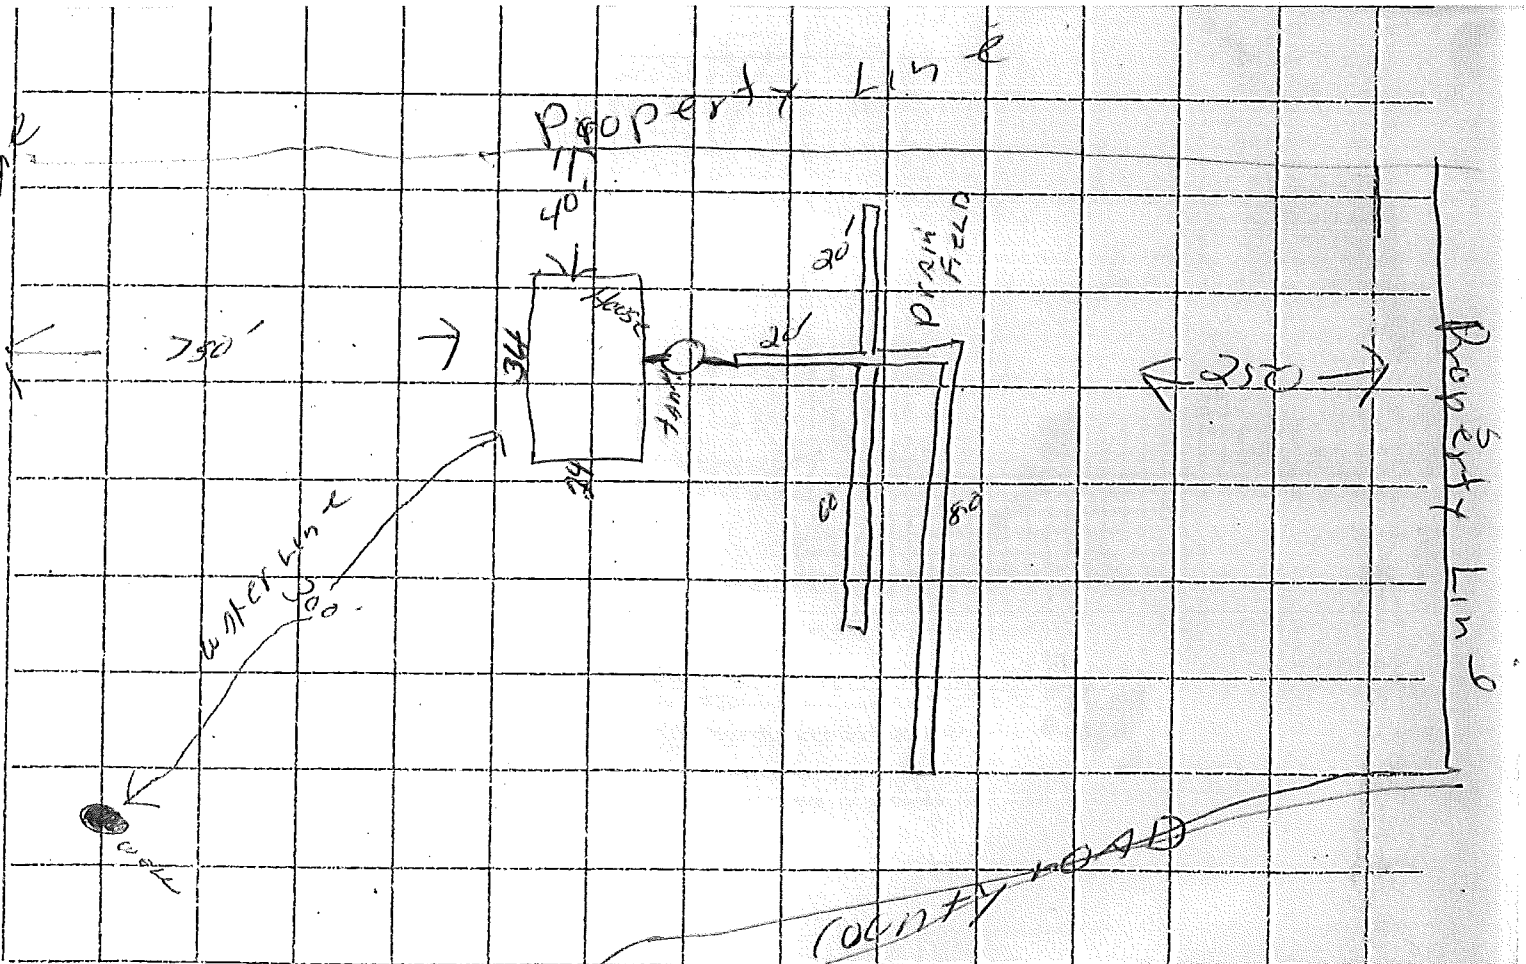

NUMBER OF BEDROOMS: 3

SEPTIC TANK:

DRAINFIELD:

30-31-41