

NORTHEAST TRI COUNTY HEALTH DISTRICT  
DIVISION OF ENVIRONMENTAL HEALTH

ON-SITE SEWAGE SYSTEM PERMIT # PT0020015

Dave Ghramm is hereby authorized to utilize a sewage disposal system at  
KETTLE FALLS COLUMBIA PINES LOT 1 BLK 1

Section: 23      Township: 36      Range: 37      Parcel #: 0307600

in accordance with the plans and specifications approved by the District Health Officer on file in this office.

Prior to any major repairs, replacements or alterations to the system a permit shall be obtained from the Northeast Tri County Health District (Division of Environmental Health).

This permit is issued and may be revoked by the Northeast Tri County Health District Health Officer by authority of WAC 246-272, and Northeast Tri County Health District Regulations established by the Board of Health pursuant to RCW 70.05.

Additional permits from other jurisdictions or agencies may be necessary for this project. It is the responsibility of the applicant to acquire said permit(s), and comply with all applicable rules, regulations and/or ordinances.



Date Issued: 08/30/2021

District Health Officer

PERMIT INSTRUCTIONS

STRUCTURE TYPE: Single-Family Residential

NUMBER OF BEDROOMS: 3

DESIGN FLOW (gal/day): 360

TYPE OF SYSTEM: Replacement

SYSTEM DESIGN: Gravity w/ Gravelless Chambers

SEPTIC TANK CAPACITY (gal): 1000

DFLF/BED DIMENSIONS: 10x45

TRENCH DEPTH (inches): 32

TRENCH WIDTH (inches):

APPURTENANCES: Effluent Filter

PUMP CHAMBER (y/n):

PUMP CHAMBER GALLONS:

REASON FOR SYSTEM DESIGN: 25% reduction from 600' sq  
for chambers

SPECIAL PERMIT INSTRUCTIONS: reduced length 10x45

FINAL INSPECTION DATE: 8/31/21

Initials: BH


Stevens County Office	240 E Dominion	Colville,	WA	99114	(509) 684-2262
Pend Oreille County Office	605 Hwy 20	Newport,	WA	99156	(509) 447-3131
Ferry County Office	P.O. Box 584	Republic,	WA	99166	(509) 775-3111



# On-Site Sewage System As-Built Drawing for Permit # PT 20015

Inspection Date	8/31/21	Approved <input checked="" type="checkbox"/> Yes <input type="checkbox"/> No	Approved Date	8/31/21
Inspection By	BH		Re-Inspection Date	

\* Public Water System  
 Replacement of DF only

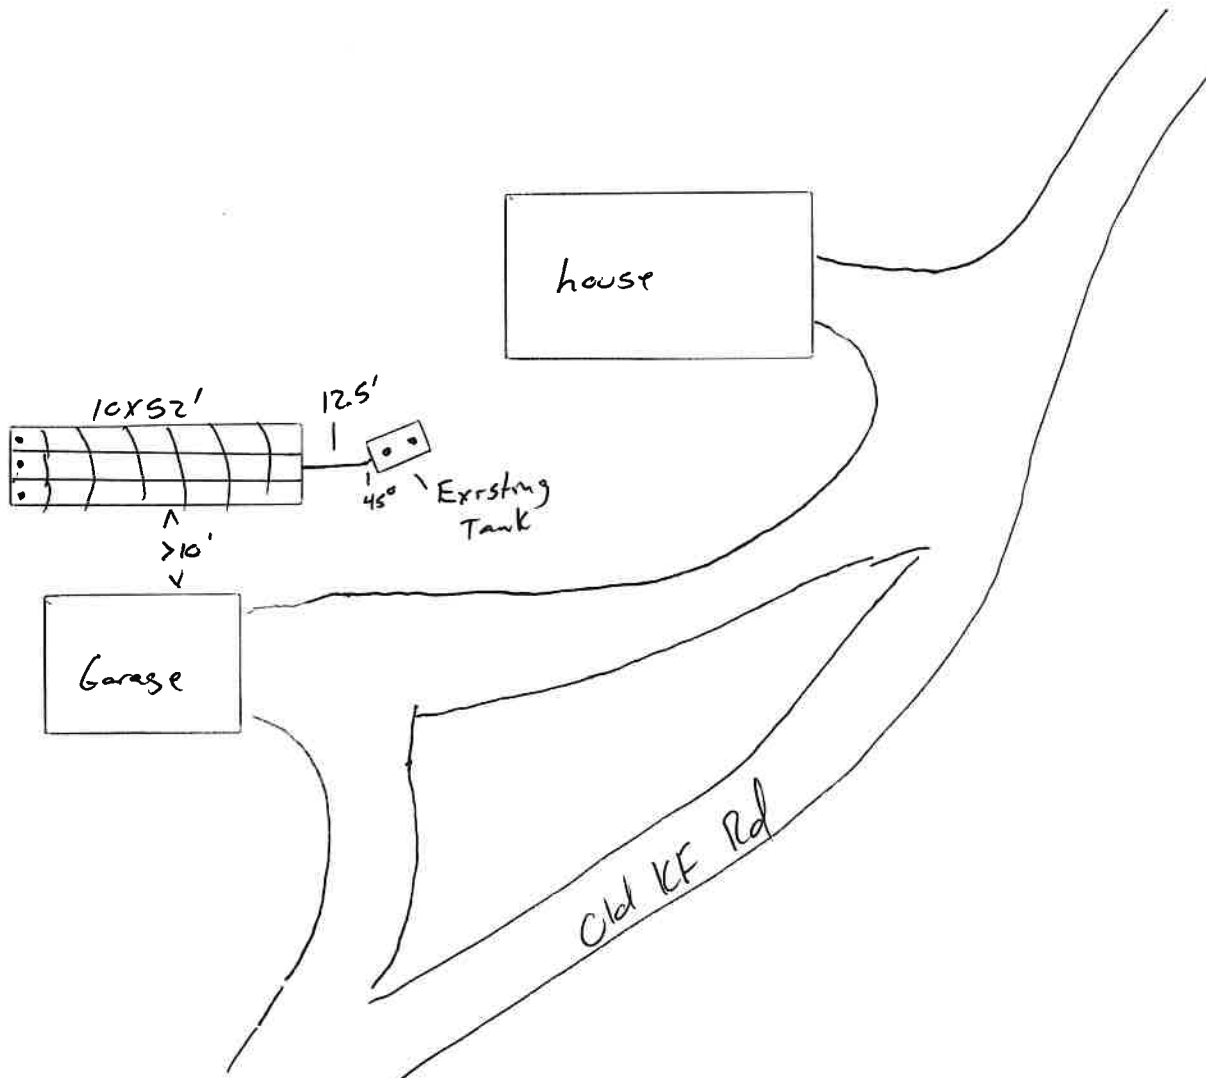

Installer Name	Vance Durpos		Pump Chamber Size	
Septic Tank Size	1000 existing	Dose/day	Gallons/Dose	
Drainfield Length	10x52	Squirt Height	Drawdown	
Drainfield Depth	32	Pump Run Time		
Septic Tank Latitude/Longitude	48.5945 / -118.1108			