


Lots 11 & 12 Kettle River Park Estates No 3 / Block # 738 205 100 11000
Ferry County WA

Owner: Jack Peters
PO 399

Springdale, WA 99193
(509) 999-7115

Installer: Durpos
Construction
(509) 675-0540

"Not to Scale"

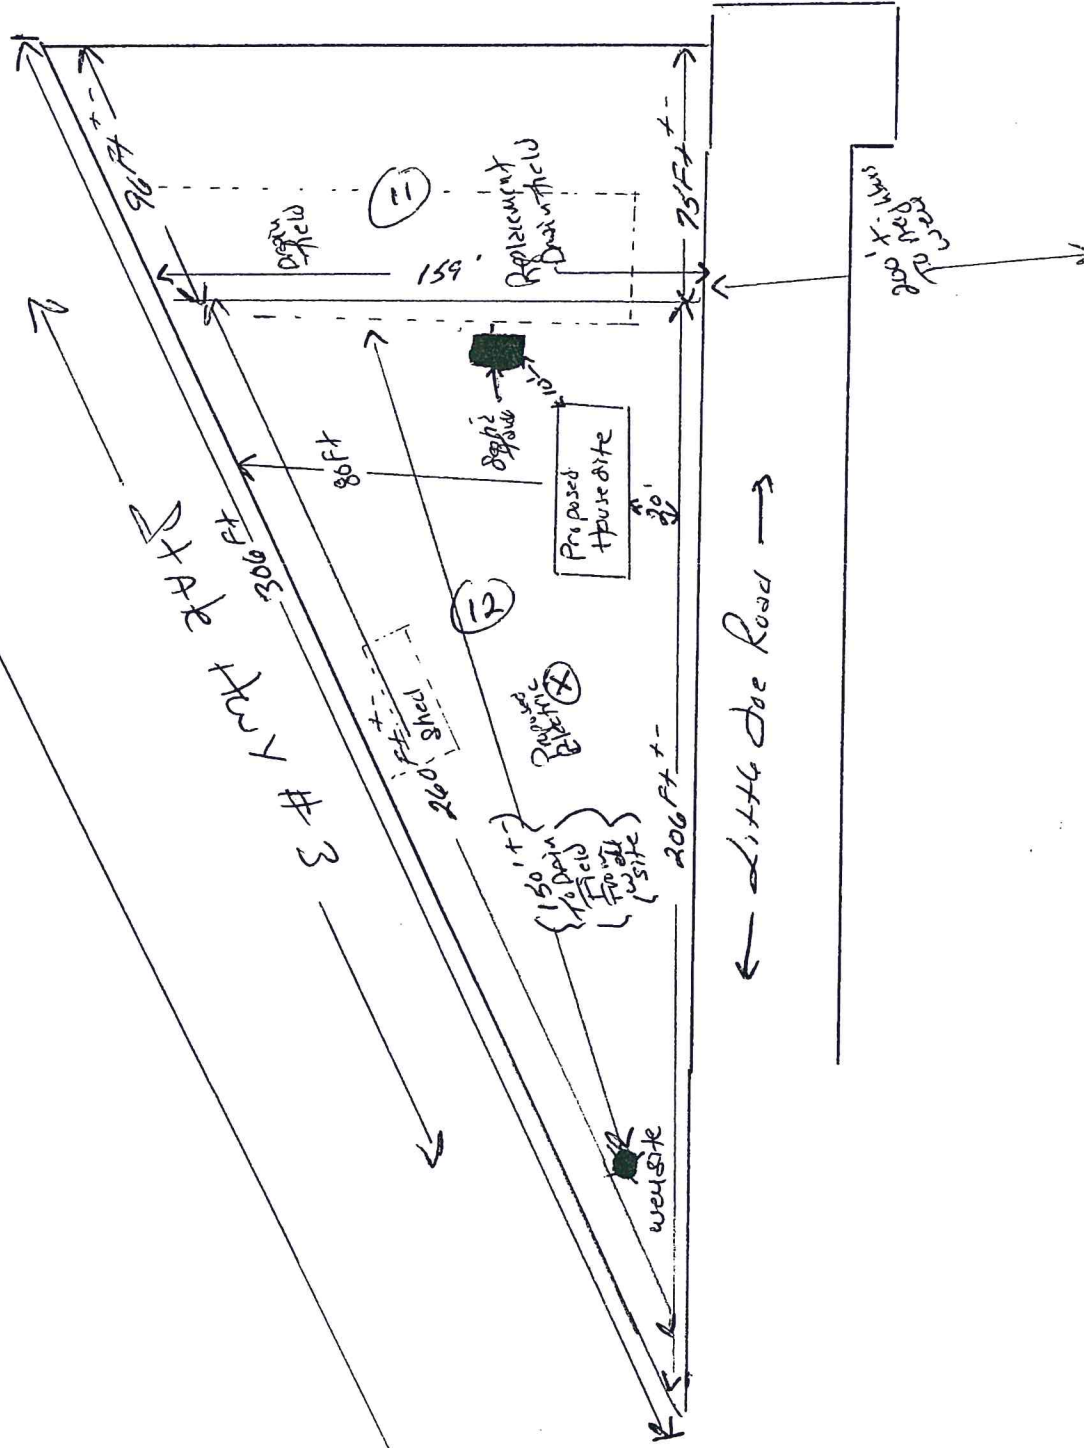

FERRY COUNTY,


INGTON

Mickey - 501 - 4380
687
Stewart County title

UNPLATTED

S 88° 00' 37" W - 1315.94'
640.95'

N 2° 17' 45" W

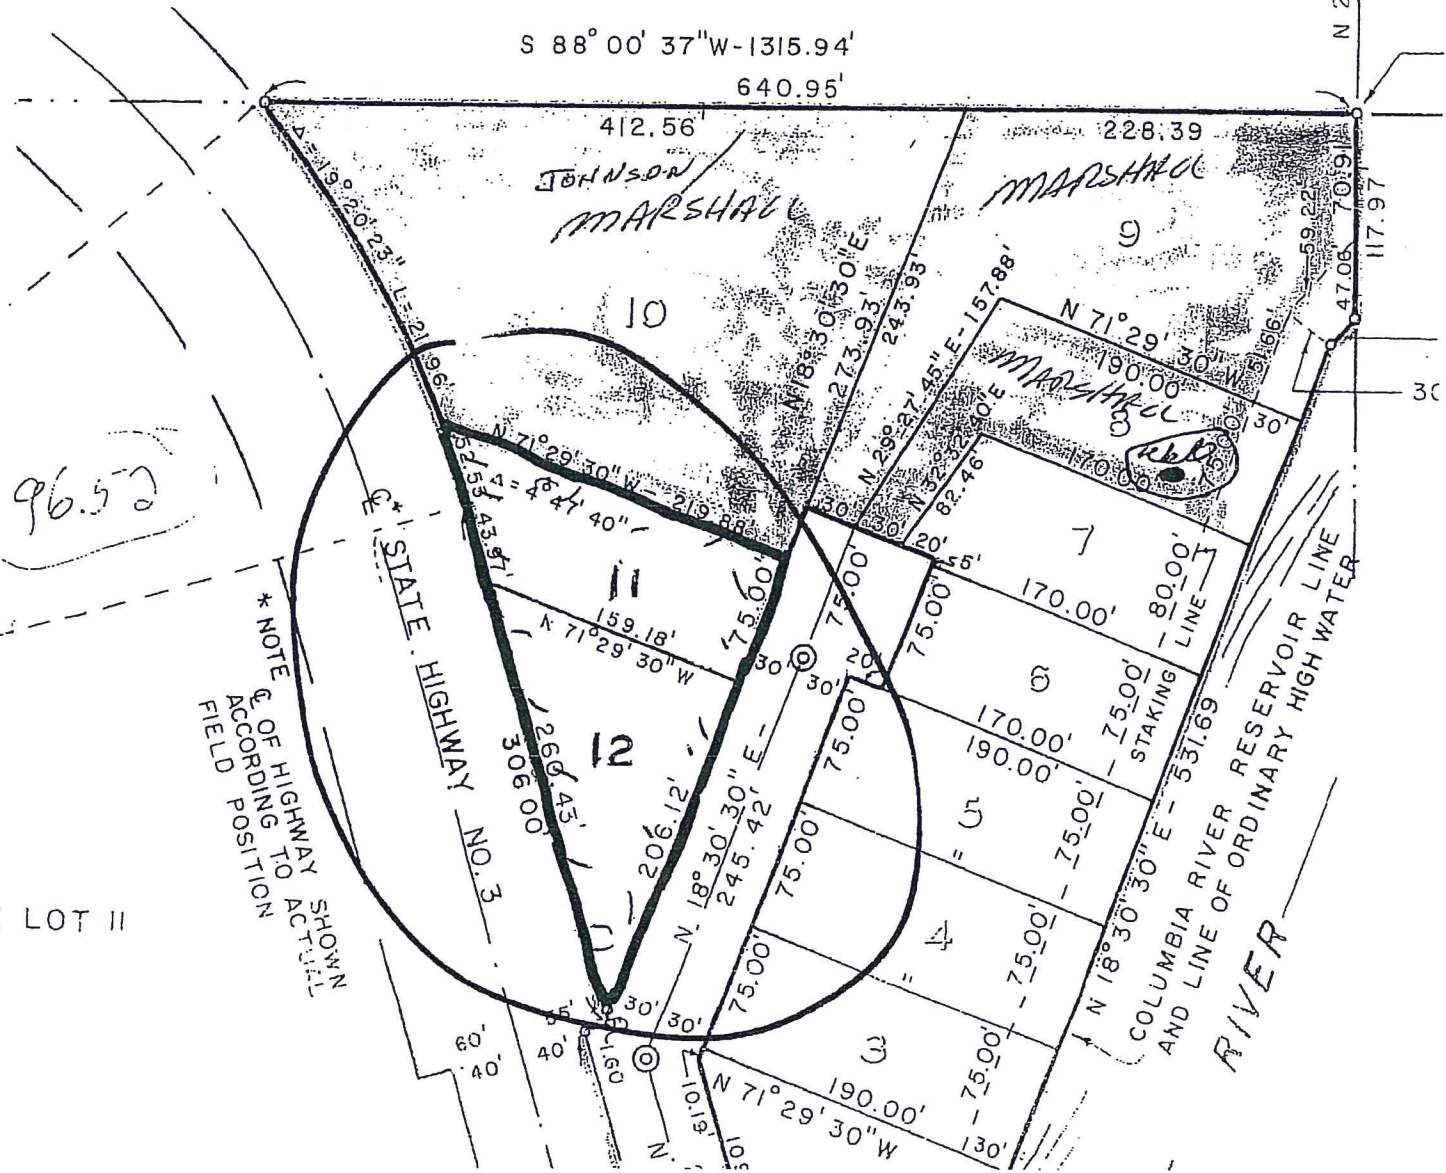

96.52

* NOTE
OF HIGHWAY ACTUALLY
ACCORDING TO
FIELD POSITION
SHOWN

T. LOT II