

03/14/2016 MON 13:53 FAX

002/003

SR 2951

Septic Tank	1000	Gals.
Disp. Field	200	L.F.T
Other		
00 New		
() Repair		

NORTHEAST TRI-COUNTY HEALTH DISTRICT
 Division of Environmental Health
 () Colville Office, Box 270, Phone 684-2262
 () Newport Office, Box 490, Phone 447-3131
 () Republic Office, Box 584, Phone 775-3111

Permit No. c 10764Fee Paid \$225.00Receipt No. 014647

Bob Rodzelek is hereby authorized to utilize a sewage disposal

Sec 33 TRp 35 Rng 37
 system at E2 NE4 SW4 SW4, E2 W2 NE4 SW4 SW4, SE4 SW4 SW4 and in accordance
 with the plans and specifications approved by the District Health Officer on file in this office.

Any major repairs or alterations to the system shall be reported to the Northeast Tri-County Health District (Division of Environmental Health) for approval PRIOR to construction.

This permit is issued and may be revoked by the Northeast Tri-County Health District Health Officer by the authority of WAC 246-272, and Rules and Regulations established by the Board pursuant to RCW 70.05.

Witness my hand and seal this 27th day of August, 1996

Date of Inspection 6-23-97 df

[Signature]
 District Health Officer

C 10764


33-35-37

03/14/2016 MON 13:53 FAX

0003/003

~~PROCESSED UNDER 100% BY THE~~
~~PROPERTY NAME~~ **SR 2951**

Bob Rodreick
6-23-97
of

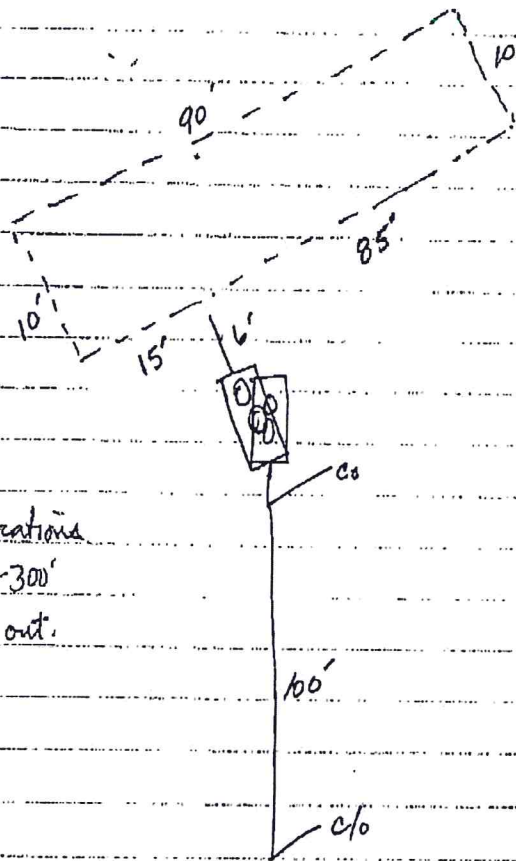

* House & well locations
to be added 100-300'
from end clean out.

Feature
House