

Septic Tank 1000 Gals.
 Disp. Field 200' L.F.T.
 Other _____
☒ New _____
☐ Repair _____

*Renewed
 7/7/94
 Receipt #
 658215
 Renewed
 6/2/95
 Rec. # 0011717*

NORTHEAST TRI-COUNTY HEALTH DISTRICT

Division of Environmental Health

- (*) Colville Office, Box 270, Phone 684-2262
 () Newport Office, Box 490, Phone 447-3131
 () Republic Office, Box 584, Phone 775-3161

Permit No. C7718

Fee Paid \$150.00

Receipt No. 909770

Thomas E. robinson is hereby authorized to utilize a sewage disposal system at Lots INC 107 Block 26 KF Columbia View Sec 23 Twp 36 Rng 37 and in accordance with the plans and specifications approved by the District Health Officer on file in this office.

Any major repairs or alterations to the system shall be reported to the Northeast Tri-County Health District (Division of Environmental Health) for approval PRIOR to construction.

This permit is issued and may be revoked by the Northeast Tri-County Health District Health Officer by the authority of WAC 248-96, and Rules and Regulations established by the Board pursuant to RCW 70.05.

Witness my hand and seal this 30th day of April, 19 93

partial final 12.4.95 BSM

Date of Inspection 4.17.96 BSM


D.P. Form No. 6134-B

[Signature]
 District Health Officer
 HEALTH OFFICER

SR 2612
 C 7718
 Lot 1-7 B/K 20
 Kettle Falls Columbia View


DIRECTIONS: Take Hwy. 395 West to Peachcrest Rd.
Follow Peachcrest Rd 1 mile.

SR 2612

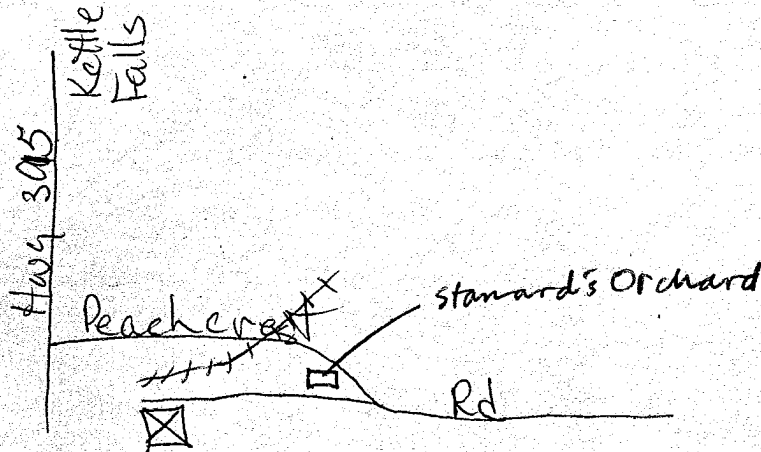

FOR OFFICE USE ONLY BELOW THIS LINE

12.4.95 Partial
As-built

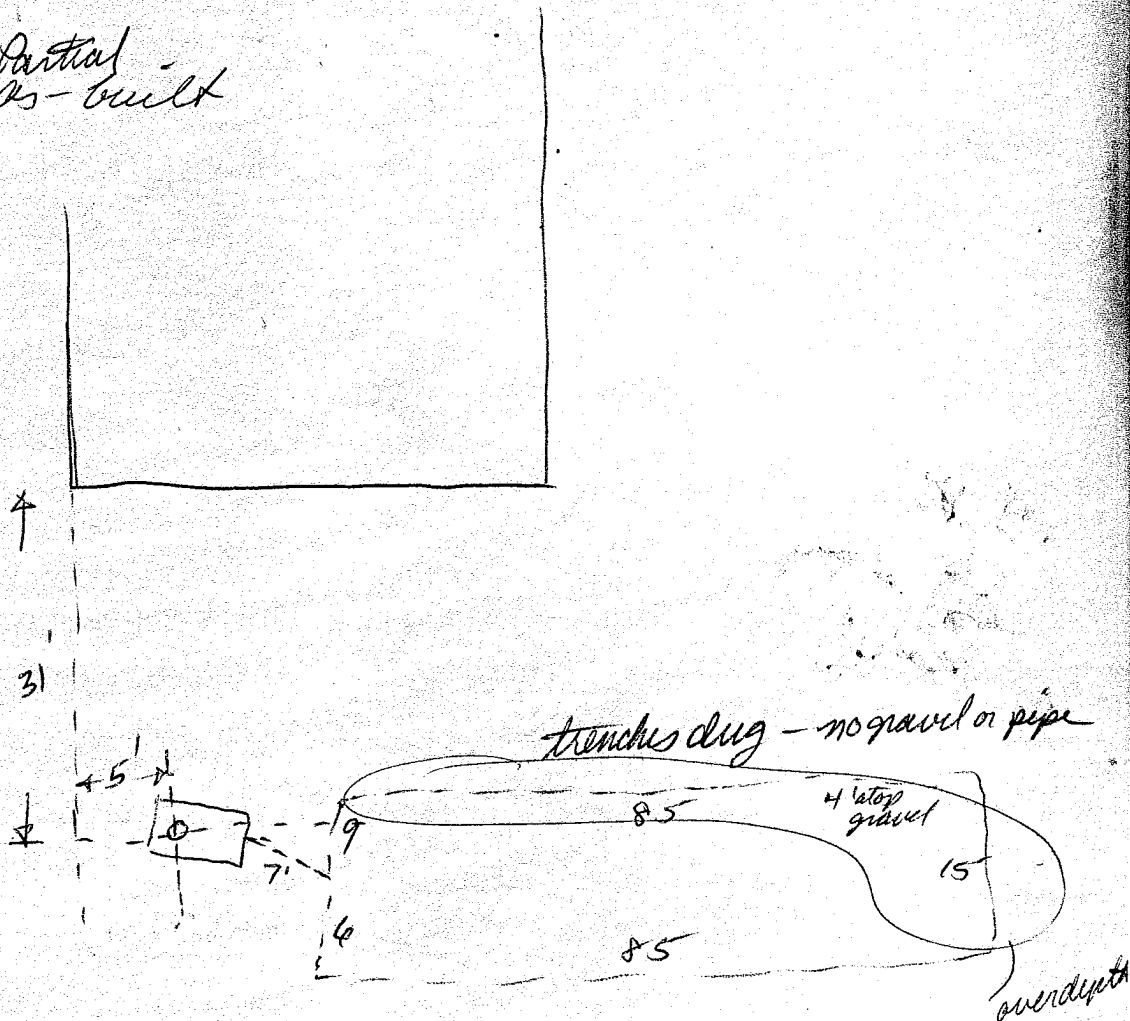

1.25.96 Second partial final. Will need to cut
ditch side area