

JK 6049

✓ 210114

35-56-51

Septic Tank 1000 Gals.

Disp. Field 300* L.F.T

Other _____

(☒) New _____

() Repair _____

Blended
9-18-96
Rec. 014924

NORTHEAST TRI-COUNTY HEALTH DISTRICT

Division of Environmental Health

(☒) Colville Office, Box 270, Phone 684-2262

() Newport Office, Box 490, Phone 447-3131

() Republic Office, Box 584, Phone 775-3161

Permit No. c 10114

Fee Paid \$200.00

Receipt No. 0012154

*26" max. trench depth *ok of*

Maurice & Donna Williamson

is hereby authorized to utilize a sewage disposal

system at Tax # 12 & 13 Sec 35 Twp 36 Rng 39 and in accordance with the plans and specifications approved by the District Health Officer on file in this office.

Any major repairs or alterations to the system shall be reported to the Northeast Tri-County Health District (Division of Environmental Health) for approval PRIOR to construction.

This permit is issued and may be revoked by the Northeast Tri-County Health District Health Officer by the authority of WAC 246-272, and Rules and Regulations established by the Board pursuant to RCW 70.05.

Witness my hand and seal this 19th day of September, 19 95

Date of Inspection 7-11-97 DAT


[Signature]

Williamson - As Built

7-11-97

Permit No.

DAY

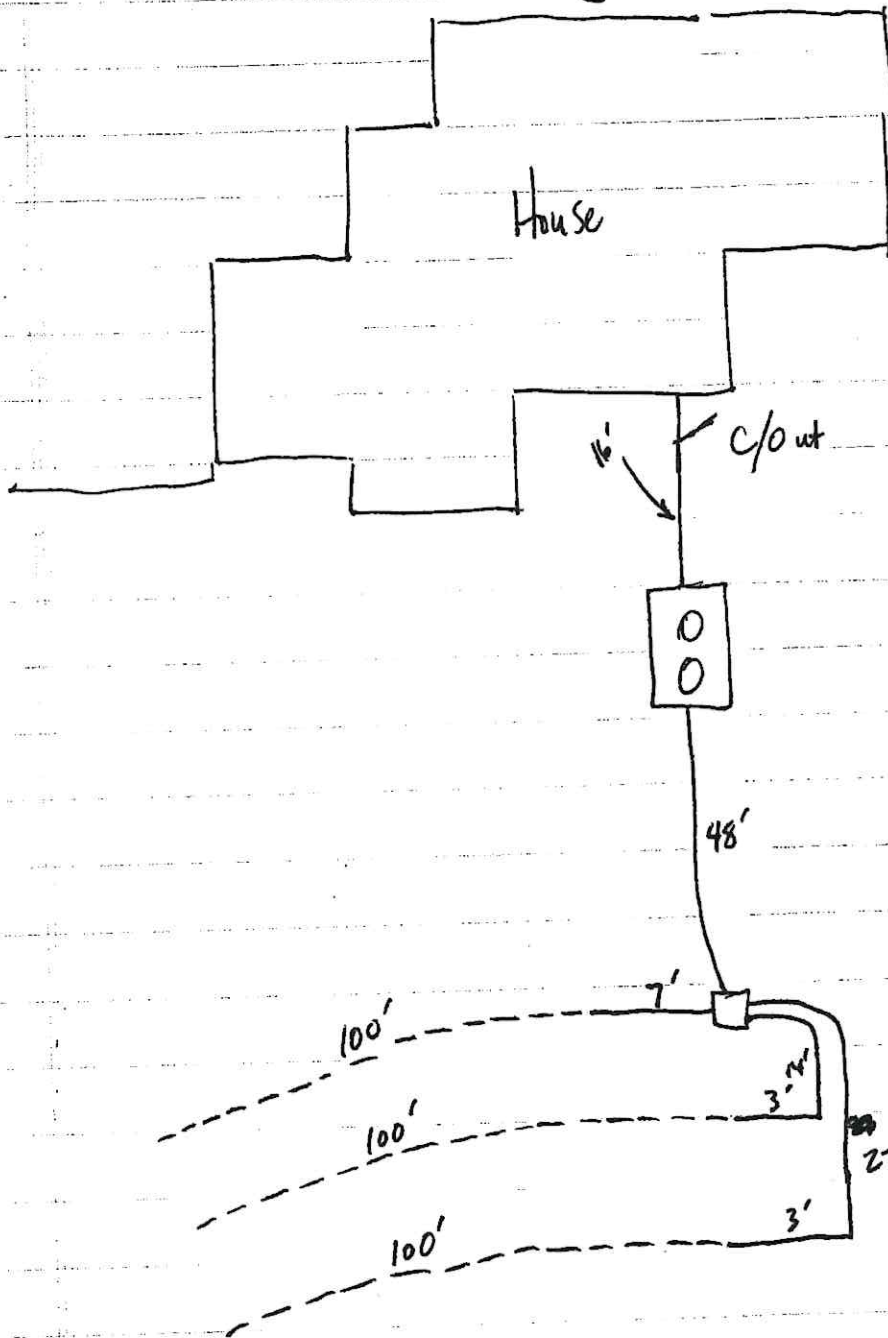



Michel Pitts <michel@colvillerealestate.com>

OSS Search Request #5471

2 messages

Angela Schoenthal <aschoenthal@netchd.org>
To: Michel Pitts <michel@colvillerealestate.com>

Mon, Mar 2, 2026 at 7:44 AM

Good morning,

Please find attached the results of your sewage search request.

Permit #: C10114

of Bedrooms Permitted: 3

Thank you,

Angela Schoenthal

Lead Administrative Assistant

Northeast Tri County Health District

aschoenthal@netchd.org

Office: 509-775-3111

Direct: 509-563-8043

www.netchd.org



CONFIDENTIALITY NOTICE: This email, including any attachments, may contain confidential information which is intended only for the use of the recipient(s) named. If you receive this email message in error, please immediately notify the sender by email and delete it. Dissemination, forwarding, printing, or copying of this email without prior consent of the sender is strictly prohibited.

This email may be considered subject to the Public Records Act and as such may be disclosed to a third-party requestor.

2 attachments

 **ON5578.pdf**
134K