



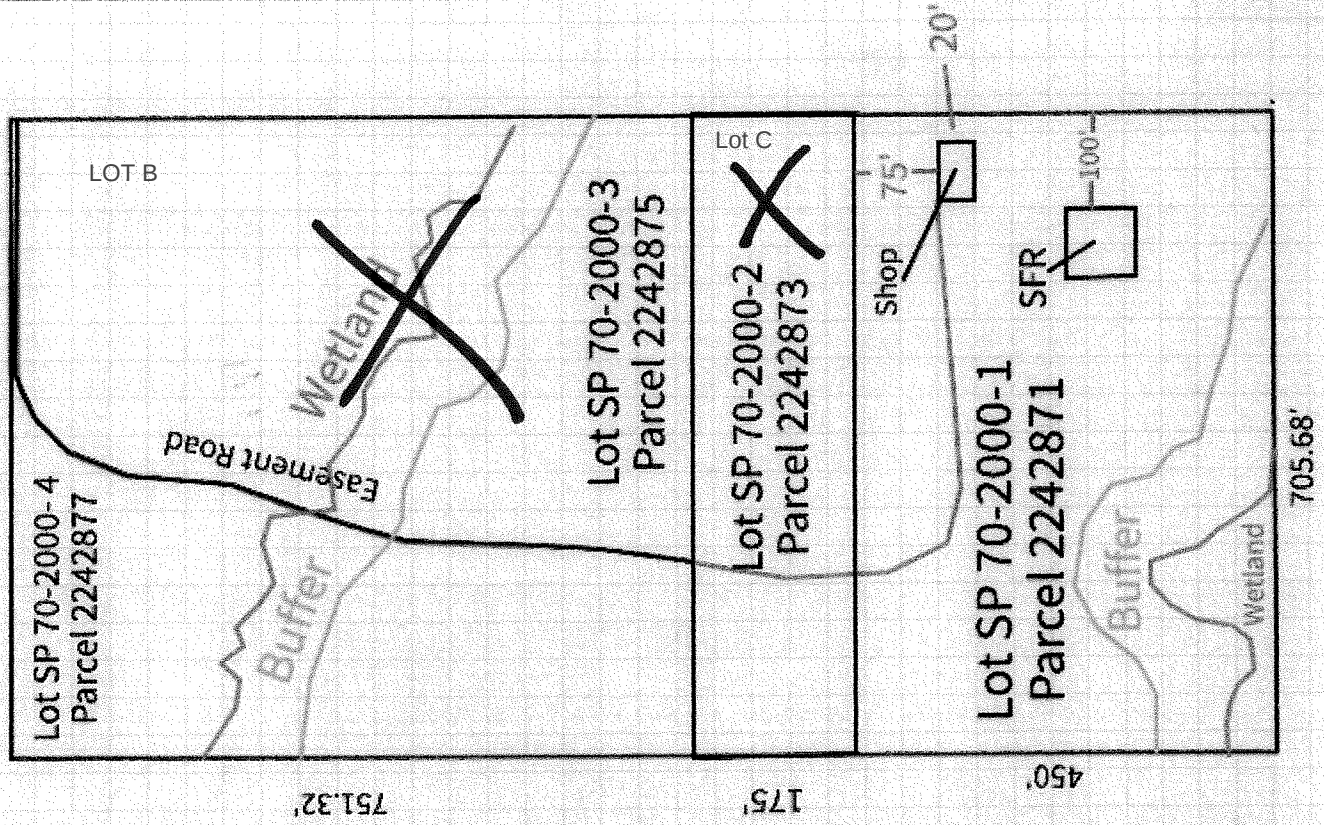

New Lot Lines SP 70-2000

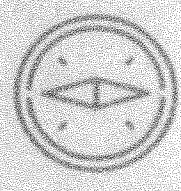

True North Planning Solutions
 2599 Ravens Way
 Chewelah, WA 99109
 (509) 934-3393