

**NORTHEAST TRI COUNTY HEALTH DISTRICT
DIVISION OF ENVIRONMENTAL HEALTH**

ON-SITE SEWAGE SYSTEM PERMIT # PT0019267

Stephen Thueringer (Phillip Humble) is hereby authorized to utilize a sewage disposal system at NE4 SW4 SE4, Is tax #6 (V 4/19/78)

Section: 24 Township: 36 Range: 39 Parcel #: 2297300

in accordance with the plans and specifications approved by the District Health Officer on file in this office.

Prior to any major repairs, replacements or alterations to the system a permit shall be obtained from the NorthEast Tri County Health District (Division of Environmental Health).

This permit is issued and may be revoked by the NorthEast Tri County Health District Health Officer by authority of WAC 246-272, and Northeast Tri County Health District Regulations established by the Board of Health pursuant to RCW 70.05.

Additional permits from other jurisdictions or agencies may be necessary for this project. It is the responsibility of the applicant to acquire said permit(s), and comply with all applicable rules, regulations and/or ordinances.



Date Issued: 11/18/2019

District Health Officer

PERMIT INSTRUCTIONS

STRUCTURE TYPE: Single-Family Residential

NUMBER OF BEDROOMS: 3

DESIGN FLOW (gal/day): 360

TYPE OF SYSTEM: New

SYSTEM DESIGN: Gravity

SEPTIC TANK CAPACITY(gal): 1000

DFLF/BED DIMENSIONS: 200

TRENCH DEPTH (inches): 27

TENCH WIDTH (inches): 36

APPURTANENCES: Distribution Box

PUMP CHAMBER (y/n):

PUMP CHAMBER GALLONS:

REASON SYSTEM DESIGN:

SPECIAL PERMIT INSTRUCTIONS:

FINAL INSPECTION DATE: 11/20/19


Initials: BH

Stevens County Office	240 E Dominion	Colville, WA	99114	(509) 684-2262
Pend Oreille County Office	605 Hwy 20	Newport, WA	99156	(509) 447-3131
Ferry County Office	P.O. Box 584	Republic, WA	99166	(509) 775-3111



On-Site Sewage System As-Built Drawing for Permit # PT 19267

Inspection Date	11/20/19	Approved ☒ Yes ☐ No	Approved Date	11/20/19
Inspection By	BH		Re-Inspection Date	

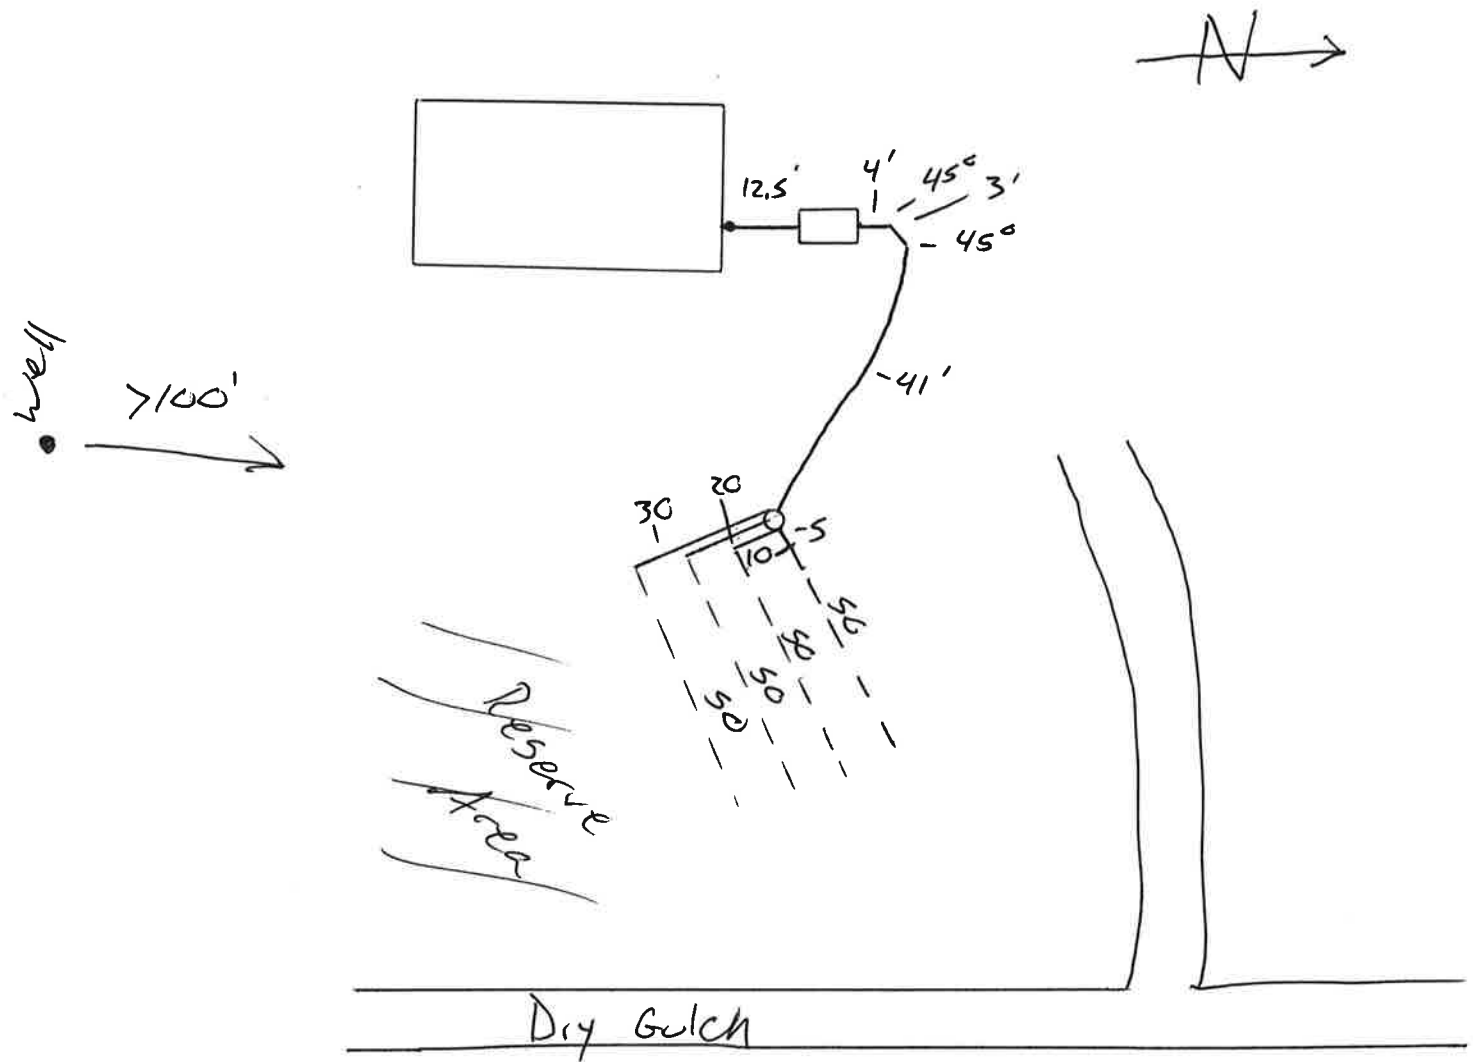

Installer Name	Vance	Pump Chamber Size	
Septic Tank Size	1000	Dose/day	Gallons/Dose
Drainfield Length	200	Squirt Height	Drawdown
Drainfield Depth	27"	Pump Run Time	
Septic Tank Latitude/Longitude	48.60036 / -117.83023		