


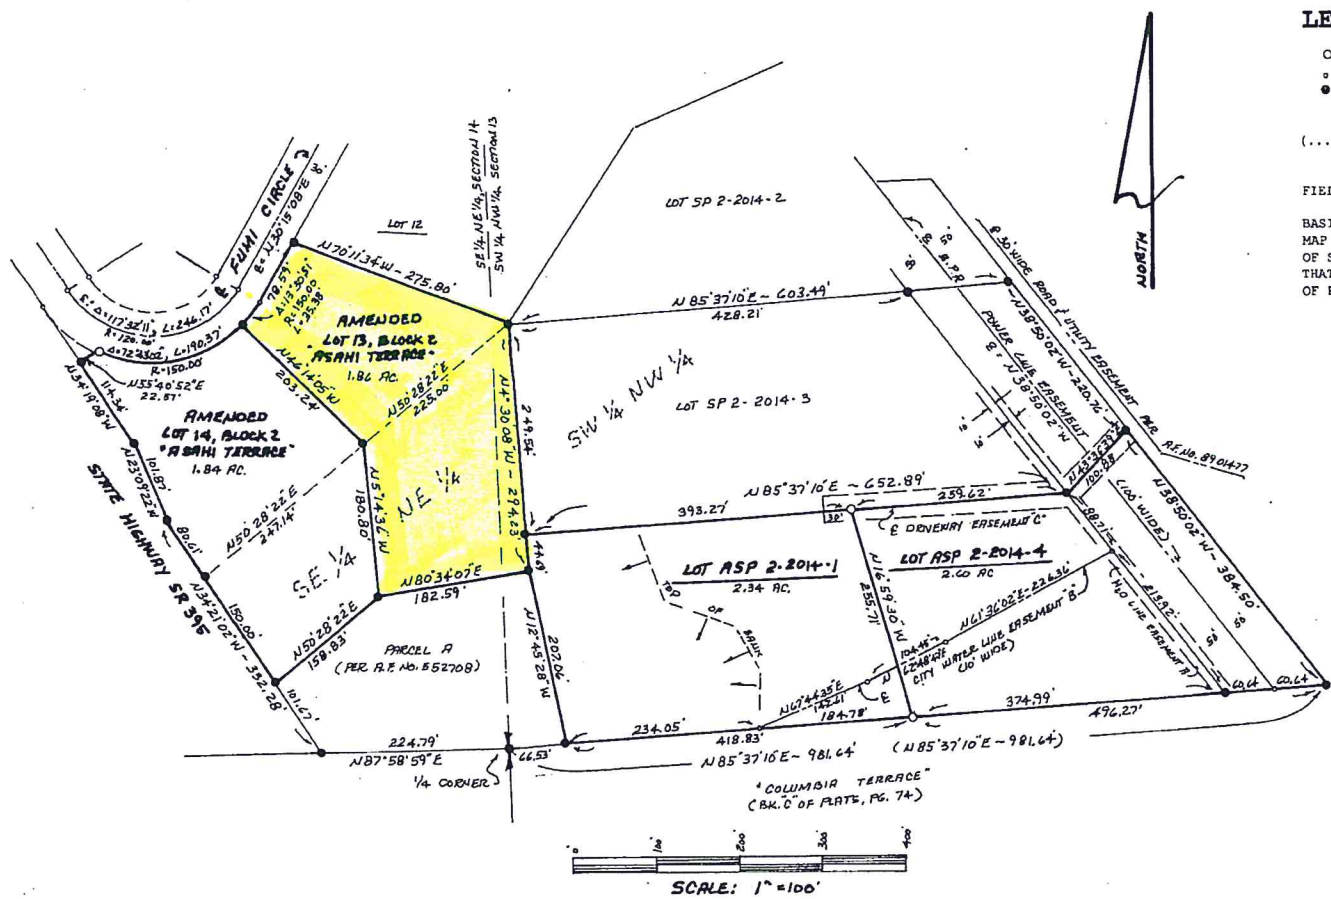

LEGEND

- SET 5/8" REBAR WITH 1 1/4" ALUM. CAP
- NO MONUMENT FOUND OR SET
- FOUND MONUMENT PER BOOK I OF SHORT PLATS BY SURVEY AT PAGES 29-31 AND/OR PER BOOK E OF PLATS AT PAGE 38
- (....) RECORD DATA PER BOOK I OF SHORT PLATS BY SURVEY AT PAGES 29-31

FIELD TRAVERSE USING TOPCON GTS-235W

BASIS OF BEARINGS AND SURVEY DATA BASED ON THAT MAP OF SHORT PLAT NO. 2-2014, RECORDED IN BOOK I OF SHORT PLATS BY SURVEY AT PAGES 29-31 AND PER THAT MAP OF "ASAHI TERRACE", RECORDED IN BOOK E OF PLATS AT PAGE 38.



SURVEYOR'S CERTIFICATE

THIS MAP CORRECTLY REPRESENTS A SURVEY MADE BY ME OR UNDER MY DIRECTION IN CONFORMANCE WITH THE REQUIREMENTS OF THE SURVEY RECORDING ACT AT THE REQUEST OF JAMES W. HARBERD IN JUNE 2017.

THOMAS E. TODD, L.S. 19648
 THOMAS E. TODD LAND SURVEYOR, LLC
 455 SOUTH OAK STREET, COLVILLE, WA. 99114
 (509) 684-8661

AUDITOR'S CERTIFICATE

FILED FOR RECORD THIS 25TH DAY OF Sept. 2017, AT 1:29 P.M., IN BOOK 37 OF SURVEYS AT PAGE 5 * AT THE REQUEST OF THOMAS E. TODD.

Tim Gray COUNTY AUDITOR
 F. Clinton DEPUTY AUDITOR
 FEE \$153.00

RECORD OF SURVEY

IN THE SW 1/4 OF THE NW 1/4 OF SECTION 13 AND IN THE SE 1/4 OF THE NE 1/4 OF SECTION 14, ALL IN T. 36 N., R. 37 E., W.M., STEVENS COUNTY, WASHINGTON.