


1

07715 2-37-38

As Built 6/16/93 MHA

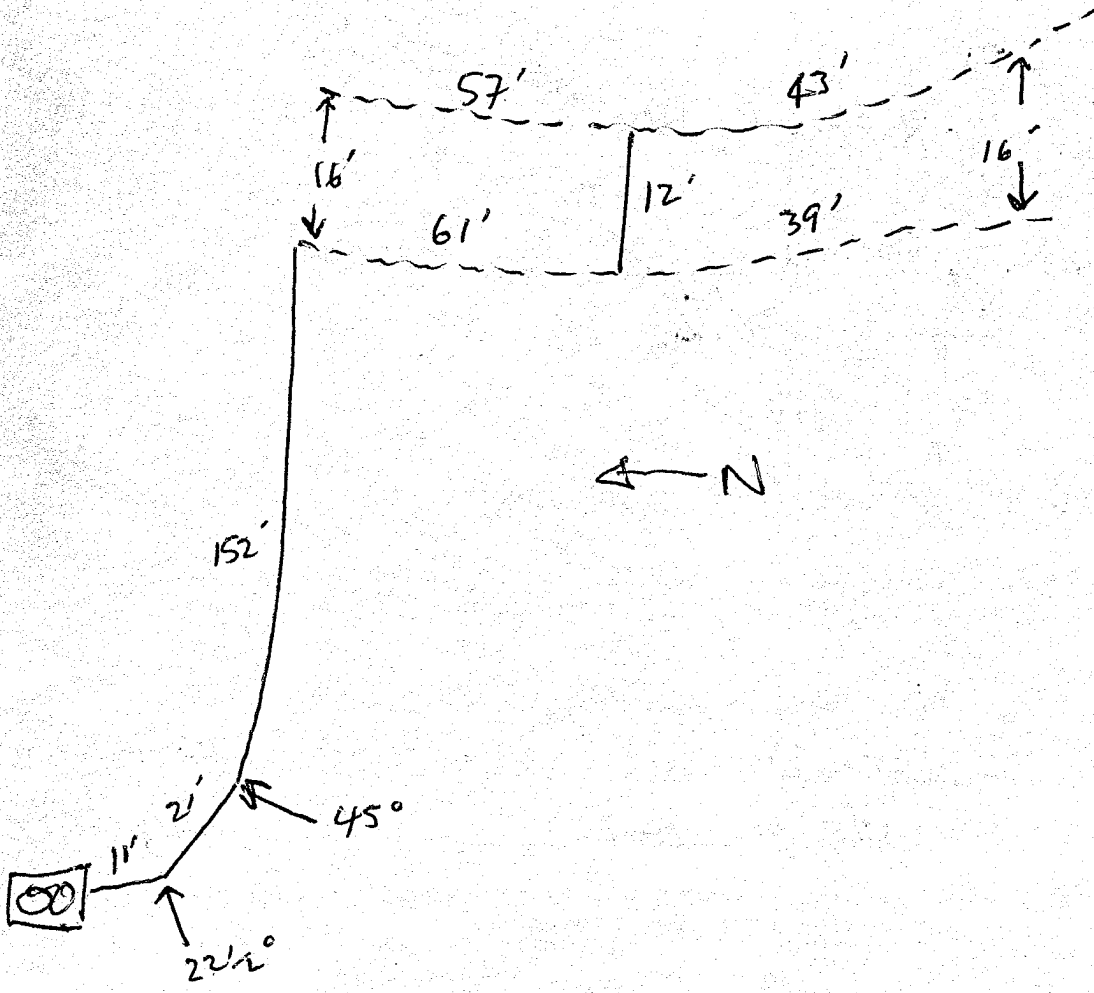

← N