

**NORTHEAST TRI COUNTY HEALTH DISTRICT
DIVISION OF ENVIRONMENTAL HEALTH**

ON-SITE SEWAGE SYSTEM PERMIT # PT0004774

Michale & Camillia McMillin is hereby authorized to utilize a sewage disposal system at
Chewelah Golf #5 Lot: 2

Section: 34 Township: 33 Range: 40 Parcel #: 932062

in accordance with the plans and specifications approved by the District Health Officer on file in this office.

Prior to any major repairs, replacements or alterations to the system a permit shall be obtained from the NorthEast Tri County Health District (Division of Environmental Health).

This permit is issued and may be revoked by the NorthEast Tri County Health District Health Officer by authority of WAC 246-272, and Northeast Tri County Health District Regulations established by the Board of Health pursuant to RCW 70.05.

Additional permits from other jurisdictions or agencies may be necessary for this project. It is the responsibility of the applicant to acquire said permit(s), and comply with all applicable rules, regulations and/or ordinances.

Date Issued: 10/27/2006



District Health Officer

PERMIT INSTRUCTIONS

STRUCTURE TYPE: Single-Family Residential

NUMBER OF BEDROOMS: 4

DESIGN FLOW (gal/day): 480

TYPE OF SYSTEM: New

SYSTEM DESIGN: Gravity

SEPTIC TANK CAPACITY (gal): 1000

DFLF/BED DIMENSIONS: 275

TRENCH DEPTH (inches): 36

TENCH WIDTH (inches): 36

APPURTANENCES:

PUMP CHAMBER (y/n): N

PUMP CHAMBER GALLONS:

REASON SYSTEM DESIGN:

SPECIAL PERMIT INSTRUCTIONS:

FINAL INSPECTION DATE: 04/11/2007

Initials:

BA

**** SEE REVERSE FOR AS BUILT DRAWING**

Stevens County Office

Pend Oreille County Office

Ferry County Office

P.O.Box 270

P.O. Box 490

P.O. Box 584

Colville,

Newport,

Republic,

WA

WA

WA

99114

99156

99166


(509) 684-2262

(509) 447-3131

(509) 775-3111

NORTHEAST TRI COUNTY HEALTH DISTRICT
AS-BUILT DRAWING - PERMIT # PT-4774

INSPECTION DATE 11/22/06 INSPECTED BY BH APPROVED: ☒ YES ☒ NO
4/11/07

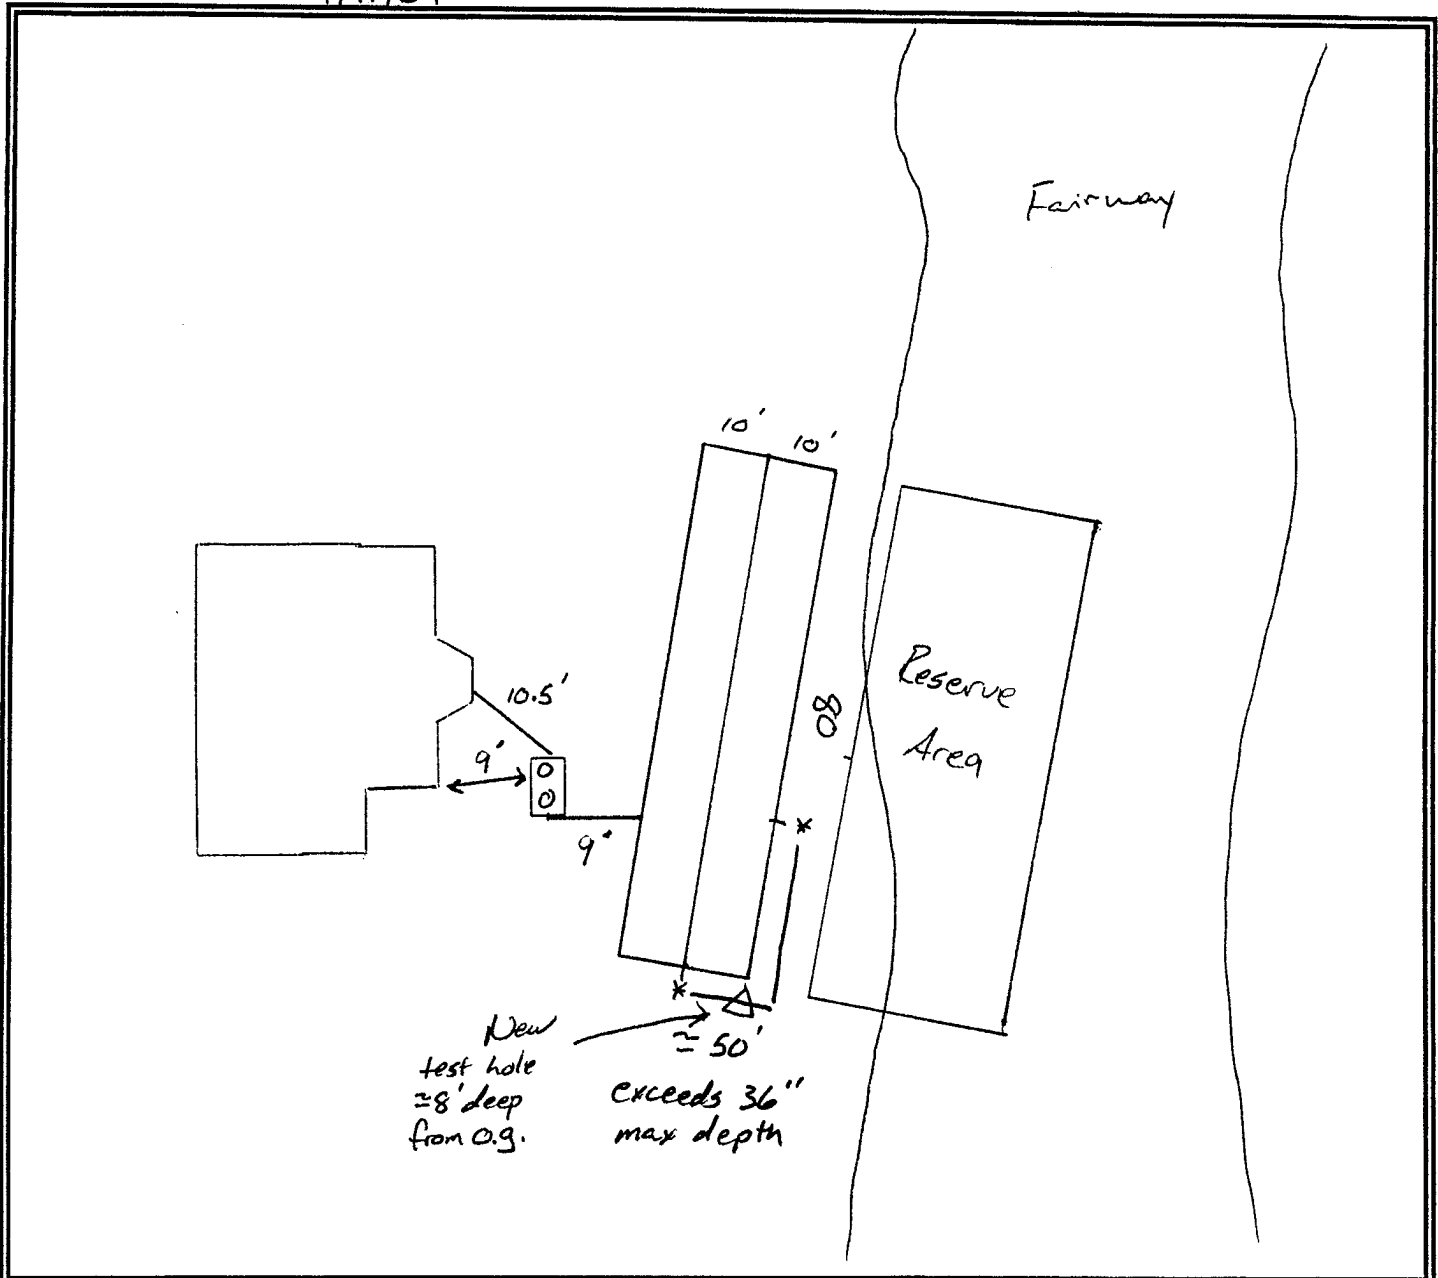

Installer Name Dale Bundy
 Septic Tank Size 1000
 Drainfield Length 200'
 Drainfield Depth 36"

Pump Chamber Size _____
 Doses/Day _____ Gallons/Dose _____
 Squirt Height _____ Drawdown _____
 Pump Run Time _____