

SK 2018

Septic Tank	1000	Gals.
Disp. Field	200*	L.F.T
Other		
(*) New		
() Repair		

NORTHEAST TRI-COUNTY HEALTH DISTRICT

Division of Environmental Health

- (x) Colville Office, Box 270, Phone 684-2262
- () Newport Office, Box 490, Phone 447-3175
- () Republic Office, Box 584, Phone 775-3161

Permit No. 103750

Fee Paid \$75.00 REC. #9050A

*Curtain Drain to be installed as per SCS recommendation

NEWPORT, James is hereby authorized to utilize a sewage disposal system at E of Rd S1 S1 SW1 NW1 of Sec. 1, Twp. 35, Rge. 38 and in accordance with the plans and specifications approved by the District Health Officer on file in this office.

Any major repairs or alterations to the system shall be reported to the Northeast Tri-County Health District (Division of Environmental Health) for approval PRIOR to construction.

This permit is issued and may be revoked by the Northeast Tri-County Health District Health Officer by the authority of WAC 248-96, and Rules and Regulations established by the Board pursuant to RCW 70.05.

Witness my hand and seal this 9 day of May, 1984.


Date of Inspection 8/23/84 Pat Sauer

HEALTH OFFICER

1003750

1-35-36

SL5048

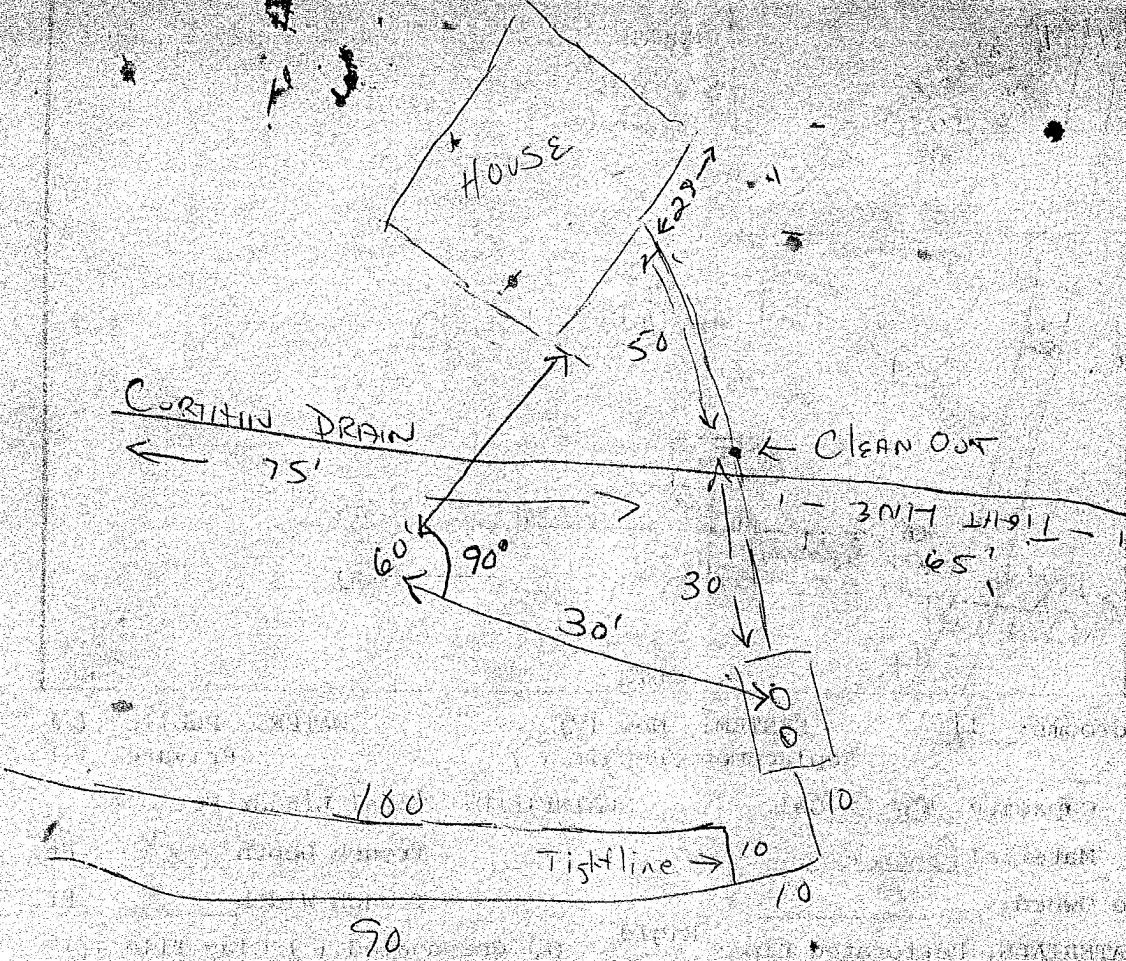

Handwritten notes and stamps on the right margin, including "SL5048" and "100'".

Handwritten notes at the bottom of the page, including "100' 90" and "Tightline".