


4xx S. Barnaby Creek Section #3

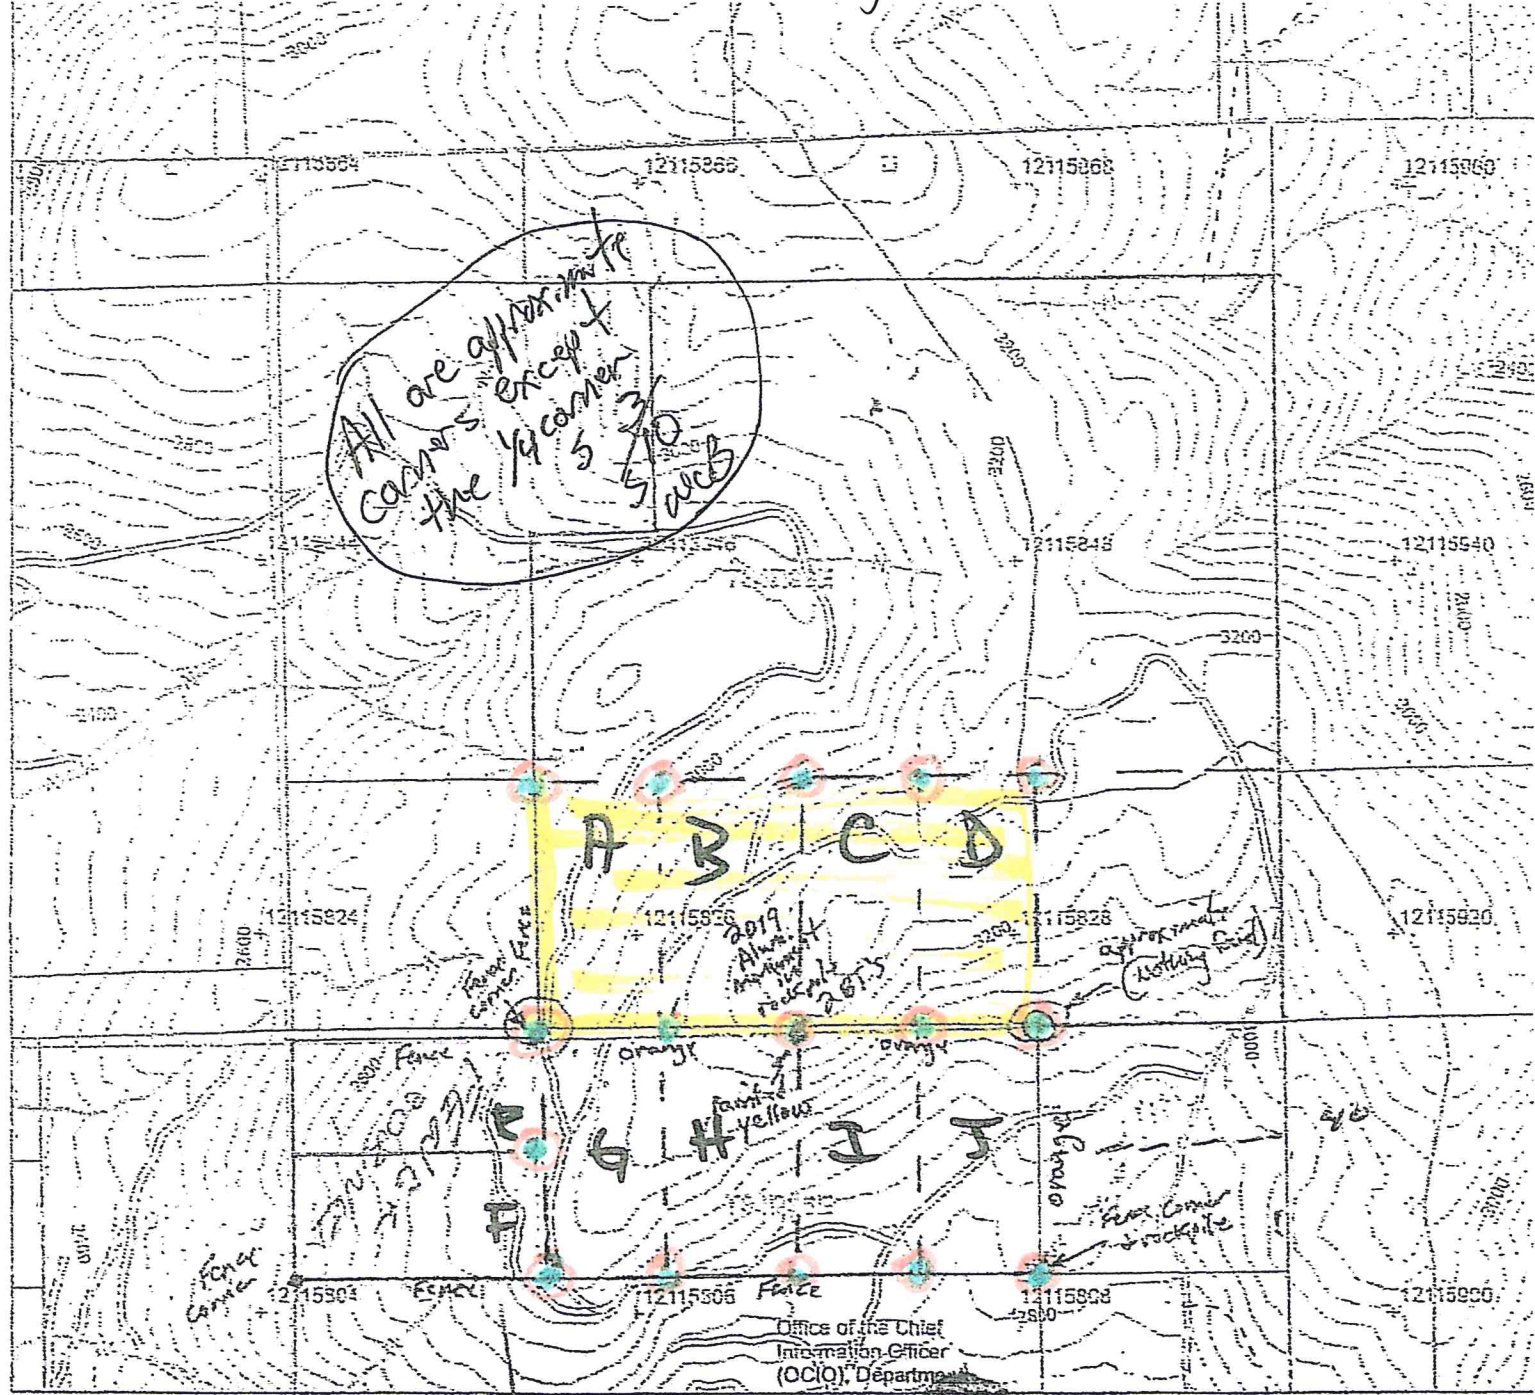

Map Symbols		Additional Information	Legal Description
---	Harvest Boundary	Approx. 1a 4s 6346311 000 1000 A-D 10/1/22 WCB	S10 T34.0N R36.0E, S11 T34.0N R36.0E
---	Road Construction		S35 T35.0N R36.0E, S36 T35.0N R36.0E
~	Stream		S04 T34.0N R36.0E, S34 T35.0N R36.0E
▨	RMZ / WMZ Buffer		S09 T34.0N R36.0E, S02 T34.0N R36.0E
X	Rock Pt		S03 T34.0N R36.0E
⊙	Landing		
▽	Waste Area		
⊕	Camped WRTS/GRTS		
⊕	Existing Structures		

Office of the Chief Information Officer (OCIO), Department of Natural Resources

Extrema care was used during the compilation of this map to ensure accuracy. However, due to changes in data and the need to rely on outside information, the Department of Natural Resources cannot be held liable for errors or omissions, and therefore, the user assumes all responsibility for the use of this map.

Scale: 0- 0.25