

The Department of Ecology does NOT Warranty the Data and/or the Information on this Well Report.

# WATER WELL REPORT

State of Washington Date Printed: **02-Aug-2005** Log No. **28605**  
 Construction / Decommission: Original Construction Notice  
 Construction 179934

**CURRENT**  
 Notice of Intent No.: **W192605**  
 Unique Ecology Well I.D. No **AKT361**  
 Water Right Permit Number:  
 OWNER: **PIPER, STEVEN & ADRIANE**

**PROPOSED USE: DOMESTIC**

**TYPE OF WORK:** Owners's Well Number: (If more than one well) **1**  
**NEW WELL** Method: **ROTARY**

**DIMENSIONS** Diameter of well: **6** inches  
 Drilled **120** ft. Depth of completed well **120** ft.

| CONSTRUCTION DETAILS:       | Casing installed    | WELDED           |               |
|-----------------------------|---------------------|------------------|---------------|
| Liner installed: <b>PVC</b> | <b>6</b> " Dia from | <b>+2</b> ft. to | <b>78</b> ft. |
| <b>4</b> " Dia from         | <b>20</b> ft. to    | <b>120</b> ft.   |               |

**Perforations: Yes** Used In: **Liner**  
 Type of perforator used **SKILL SAW**  
 SIZE of perforations **6** in. b **1/4** in.  

|  |
|--|
| <b>80</b> Perforation from <b>80</b> ft. to <b>120</b> ft. |
| Perforation from ft. to ft.                                |
| Perforation from ft. to ft.                                |

**Screens: No** K-Pac Location  
 Manufacture's Name  
 Type: Model No  
 Diam. slot size from ft. to ft.  
 Diam. slot size from ft. to ft.

**Gravel/Filter packed: No** Size of Gravel  
 Material placed fro ft. to ft.

**Surface seal: Yes** To what depth **18** ft.  
 Seal method: Material used in seal **BENTONITE**  
 Did any strata contain unusable water **No**  
 Type of water Depth of strata  
 Method of sealing strata off


**PUMP:** Manufacture's name  
 Type: H.P. **0**

OWNER ADD **PO BOX 1753**  
**ORTING, WA 98360**  
 Well Add **6171 K COYOTE CANYON RD**  
 City: **Fruitland, WA 99129** County: **Stevens**  
 Location: **NE 1/4 SW 1/4 Sec 9 T 29 R 37E EW**  
 Lat/Long: Lat Deg Lat Min/Sec  
 (s, t, r still REQUIRED) Long Deg Long Min/Sec  
 Tax Parcel No.:

**CONSTRUCTION OR DECOMMISSION PROCEDURE**

Formation: Describe by color, character, size of material and structure. Show thickness of aquifers and the kind and nature of the material in each stratum penetrated. Show at least one entry for each change in formation.

| Material                  | From       | To         |
|---------------------------|------------|------------|
| <b>BROWN SAND W/ CLAY</b> | <b>0</b>   | <b>4</b>   |
| <b>CLAY W/ BOULDERS</b>   | <b>4</b>   | <b>49</b>  |
| <b>GRANITE SANDS</b>      | <b>49</b>  | <b>65</b>  |
| <b>GRANITE BROWN SOFT</b> | <b>65</b>  | <b>103</b> |
| <b>BROKEN W/WATER</b>     | <b>103</b> | <b>104</b> |
| <b>GRANITE GRAY MED</b>   | <b>104</b> | <b>120</b> |

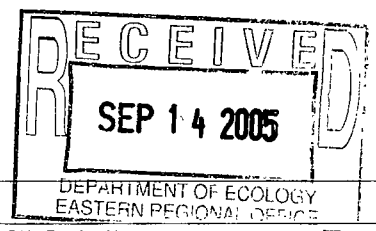

Notes:  
**SOME REALLY NIICE BOULDERS!! @ 4'-49'**

Work starte **07/25/2005** Complete **07/26/2005**

**WATER LEVELS** Land-surface elevation above mean sea level: **0** ft.  
 Static level **40** ft. below top of well Date **07/26/2005**  
 Artesian Pressure lbs per square inch Date  
 Artesian water controlled by

**WELL CONSTRUCTION CERTIFICATION:**  
 I constructed and/or accept responsibility for construction of this well and its compliance with all Washington well construction standards. Materials used and the information reported are true to my best knowledge and belief.  
 Driller  Engineer  Trainee  
 Name: **DAVID MEYER** License No.: **2427**  
 Signature: *David Meyer*

**WELL TESTS:** Drawdown is amount water level is lowered below static level.  
 Was a pump test made **No** If yes, by whom  
 Yield  gal/min with  ft drawdown after   
 Yield  gal/min with  ft drawdown after   
 Yield  gal/min with  ft drawdown after   
 Recovery data (time taken as zero when pump turned off)(water level measured from well top to water level)  

|                      |                      |                      |                      |                      |                      |
|----------------------|----------------------|----------------------|----------------------|----------------------|----------------------|
| Time:                | Water Level          | Time:                | Water Level          | Time:                | Water Level          |
| <input type="text"/> | <input type="text"/> | <input type="text"/> | <input type="text"/> | <input type="text"/> | <input type="text"/> |
| <input type="text"/> | <input type="text"/> | <input type="text"/> | <input type="text"/> | <input type="text"/> | <input type="text"/> |
| <input type="text"/> | <input type="text"/> | <input type="text"/> | <input type="text"/> | <input type="text"/> | <input type="text"/> |

 Date of test:  
 Bailer test gal/min ft drawdown after hrs.  
 Air test **7** gal/min w/ stem set at **119** ft. for **1** hours  
 Artesian flow gpm Date  
 Temperature of water Was a chemical analysis made **No**

If trainee, Licensed driller is: \_\_\_\_\_ License No.: \_\_\_\_\_  
 Licensed Driller Signature \_\_\_\_\_

**Drilling Company:**  
 NAME: **FOGLE PUMP & SUPPLY, INC.** Shop: **COLVILLE**  
 ADDRESS: **316 W. 5TH**  
**Colville, WA 99114**  
 Phone: **509-684-2569** Toll Free: **800-533-6518**  
 E-Mail: **jrs@foglepump.com**  
 FAX: **509-684-3032** WEB Site: **www.foglepump.com**  
 Contractor's  
 Registration No.: **FOGLEPS095L4** Date Log Created: **08/02/200**