


Forest Practices Activity Map - Application

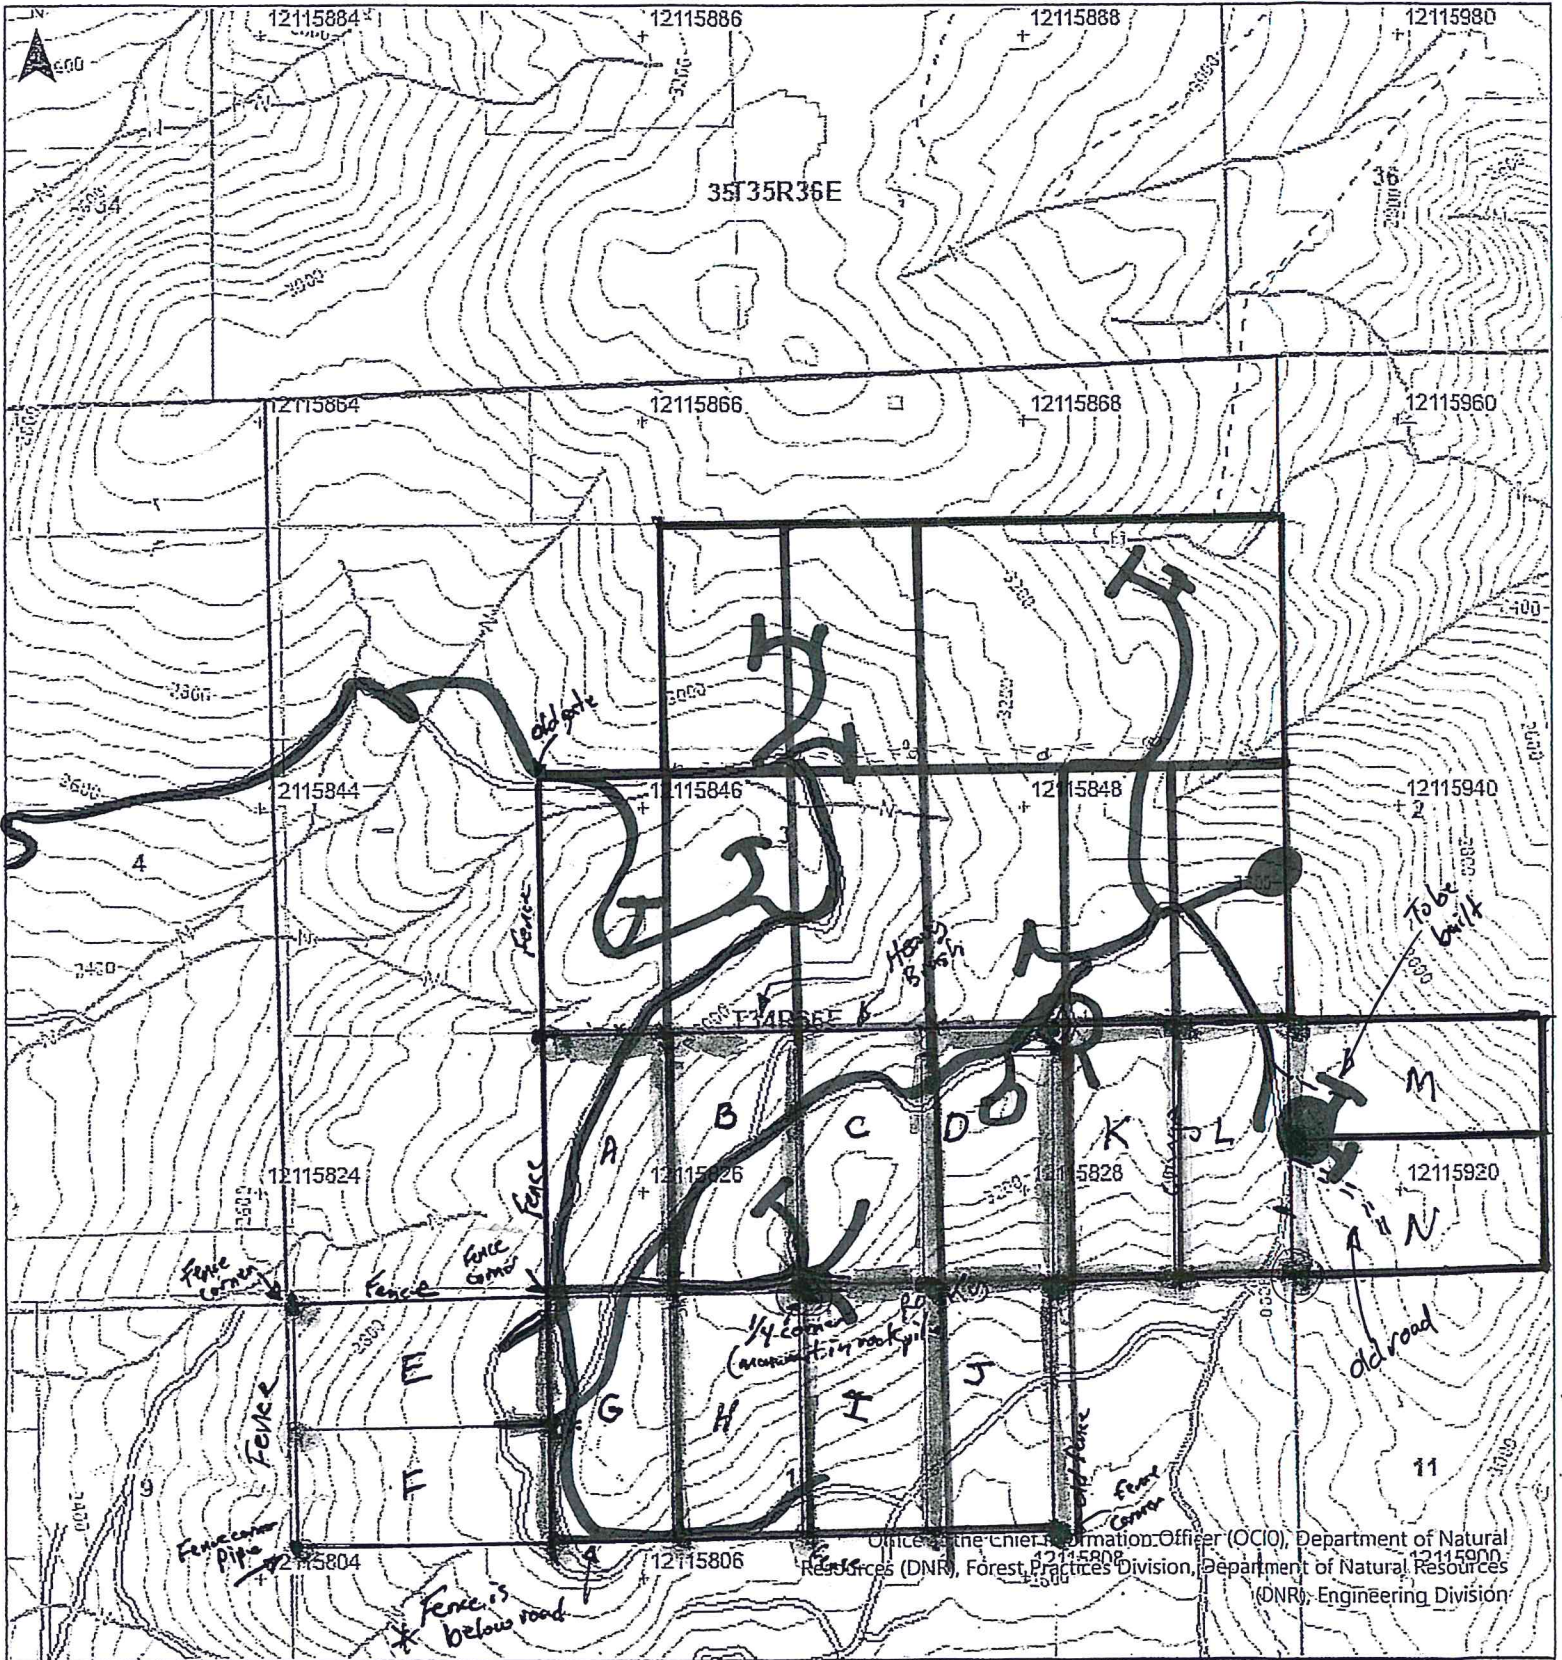

Office of the Chief Information Officer (OCIO), Department of Natural Resources (DNR), Forest Practices Division, Department of Natural Resources (DNR), Engineering Division

Map Symbols	
	Harvest Boundary
	Road Construction
	Stream
	RMZ / WMZ Buffers
	Rock Pit
	Landing
	Waste Area
	Clumped WRTS/GRTS
	Existing Structure

Additional Information

* Approx. corners and lines

Flagged lines -

Approx. corners

1/4 corner monument in rockpile

wsg
6/24/24 / 8/19/24

Legal Description

S11 T34.0N R36.0E, S09 T34.0N R36.0E, S34 T35.0N R36.0E, S35 T35.0N R36.0E, S36 T35.0N R36.0E, S04 T34.0N R36.0E, S02 T34.0N R36.0E, S03 T34.0N R36.0E, S10 T34.0N R36.0E



Extreme care was used in the compilation of this map to ensure its accuracy. However, due to changes in data and the need to rely on outside information, the Department of Natural Resources cannot accept responsibility for errors or omissions, and therefore, there are no warranties that accompany this material.

Approximate Scale: 1:12,000

Date: 6/24/2024 Time: 1:24 PM