

The Department of Ecology does NOT Warranty the Data and/or the Information on this Well Report.

File Original and First Copy with Department of Ecology  
Second Copy — Owner's Copy  
Third Copy — Driller's Copy

# WATER WELL REPORT

STATE OF WASHINGTON

Start Card No. W046916

UNIQUE WELL I.D. # ABP399

Water Right Permit No. \_\_\_\_\_

(1) OWNER: Name Paul Hurn Address 1504 Evans Cutoff Rd, Evans, WA, 99126

(2) LOCATION OF WELL: County Stevens E  $\frac{1}{2}$  SW  $\frac{1}{4}$  NE  $\frac{1}{4}$  Sec 11 T. 37 N. R 38E W.M.

(2a) STREET ADDRESS OF WELL (or nearest address) \_\_\_\_\_

(3) PROPOSED USE:  Domestic  Industrial  Municipal   
 Irrigation  Test Well  Other   
 DeWater

## (10) WELL LOG or ABANDONMENT PROCEDURE DESCRIPTION

Formation: Describe by color, character, size of material and structure, and show thickness of aquifers and the kind and nature of the material in each stratum penetrated, with at least one entry for each change of information.

(4) TYPE OF WORK: Owner's number of well (if more than one) #3  
Abandoned  New well  Method: Dug  Bored   
Deepened  Cable  Driven   
Reconditioned  Rotary  Jetted

MATERIAL	FROM	TO
sands, gravel	0	65
clay silts, broken rock	65	74
broken rock, sands,		
waterbearing 30+ GPM at 110	74	110

(5) DIMENSIONS: Diameter of well 6 inches.  
Drilled 110 feet. Depth of completed well 110 feet.

5" x 5' x .020 slot stainless screen set from 105-110

(6) CONSTRUCTION DETAILS:  
Casing installed: 6 ft. Diam. from +1 ft. to 105 ft.  
Welded  Diam. from \_\_\_\_\_ ft. to \_\_\_\_\_ ft.  
Liner installed  Diam. from \_\_\_\_\_ ft. to \_\_\_\_\_ ft.  
Threaded  Diam. from \_\_\_\_\_ ft. to \_\_\_\_\_ ft.

Perforations: Yes  No   
Type of perforator used \_\_\_\_\_  
SIZE of perforations \_\_\_\_\_ in. by \_\_\_\_\_ in.  
\_\_\_\_\_ perforations from \_\_\_\_\_ ft. to \_\_\_\_\_ ft.  
\_\_\_\_\_ perforations from \_\_\_\_\_ ft. to \_\_\_\_\_ ft.  
\_\_\_\_\_ perforations from \_\_\_\_\_ ft. to \_\_\_\_\_ ft.

Screens: Yes  No   
Manufacturer's Name Johnson  
Type stainless steel Model No. \_\_\_\_\_  
Diam. 5 Slot size .020 from 105 ft. to 110 ft.  
Diam. \_\_\_\_\_ Slot size \_\_\_\_\_ from \_\_\_\_\_ ft. to \_\_\_\_\_ ft.

Gravel packed: Yes  No  Size of gravel \_\_\_\_\_  
Gravel placed from \_\_\_\_\_ ft. to \_\_\_\_\_ ft.

Surface seal: Yes  No  To what depth? 18 ft.  
Material used in seal Bentonite  
Did any strata contain unusable water? Yes  No   
Type of water? \_\_\_\_\_ Depth of strata \_\_\_\_\_  
Method of sealing strata off \_\_\_\_\_

(7) PUMP: Manufacturer's Name \_\_\_\_\_  
Type: \_\_\_\_\_ H.P. \_\_\_\_\_


(8) WATER LEVELS: Land surface elevation above mean sea level \_\_\_\_\_ ft.  
Static level 50 ft. below top of well Date 7/7/94  
Artesian pressure \_\_\_\_\_ lbs. per square inch Date \_\_\_\_\_  
Artesian water is controlled by \_\_\_\_\_ (Cap. valve, etc.)

(9) WELL TESTS: Drawdown is amount water level is lowered below static level  
Was a pump test made? Yes  No  If yes, by whom? \_\_\_\_\_  
Yield: \_\_\_\_\_ gal./min. with \_\_\_\_\_ ft. drawdown after \_\_\_\_\_ hrs.

Recovery data (time taken as zero when pump turned off) (water level measured from well top to water level)

Time	Water Level	Time	Water Level	Time	Water Level

Date of test \_\_\_\_\_  
Bailer test \_\_\_\_\_ gal./min. with \_\_\_\_\_ ft. drawdown after \_\_\_\_\_ hrs.  
Airstest 30 gal./min. with stem set at 105 ft. for 1 hrs.  
Artesian flow \_\_\_\_\_ g.p.m. Date \_\_\_\_\_  
Temperature of water \_\_\_\_\_ Was a chemical analysis made? Yes  No

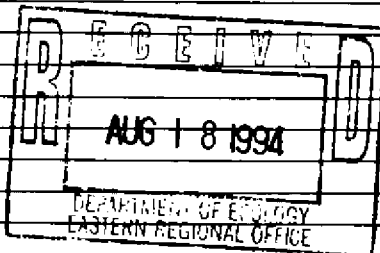

Work Started 7/6/94 19. Completed 7/7/94 19.

### WELL CONSTRUCTOR CERTIFICATION:

I constructed and/or accept responsibility for construction of this well, and its compliance with all Washington well construction standards. Materials used and the information reported above are true to my best knowledge and belief.

NAME FOGLE PUMP & SUPPLY, INC.  
(PERSON, FIRM, OR CORPORATION) (TYPE OR PRINT)

Address 316 W. 5th Colville, Wa. 99114

(Signed) Terry D. Corbitt License No. 1895  
(WELL DRILLER)

Contractor's Registration No. FOGLEPS09514 Date 7/7/94 19

(USE ADDITIONAL SHEETS IF NECESSARY)