



# Stevens County Parcel Map

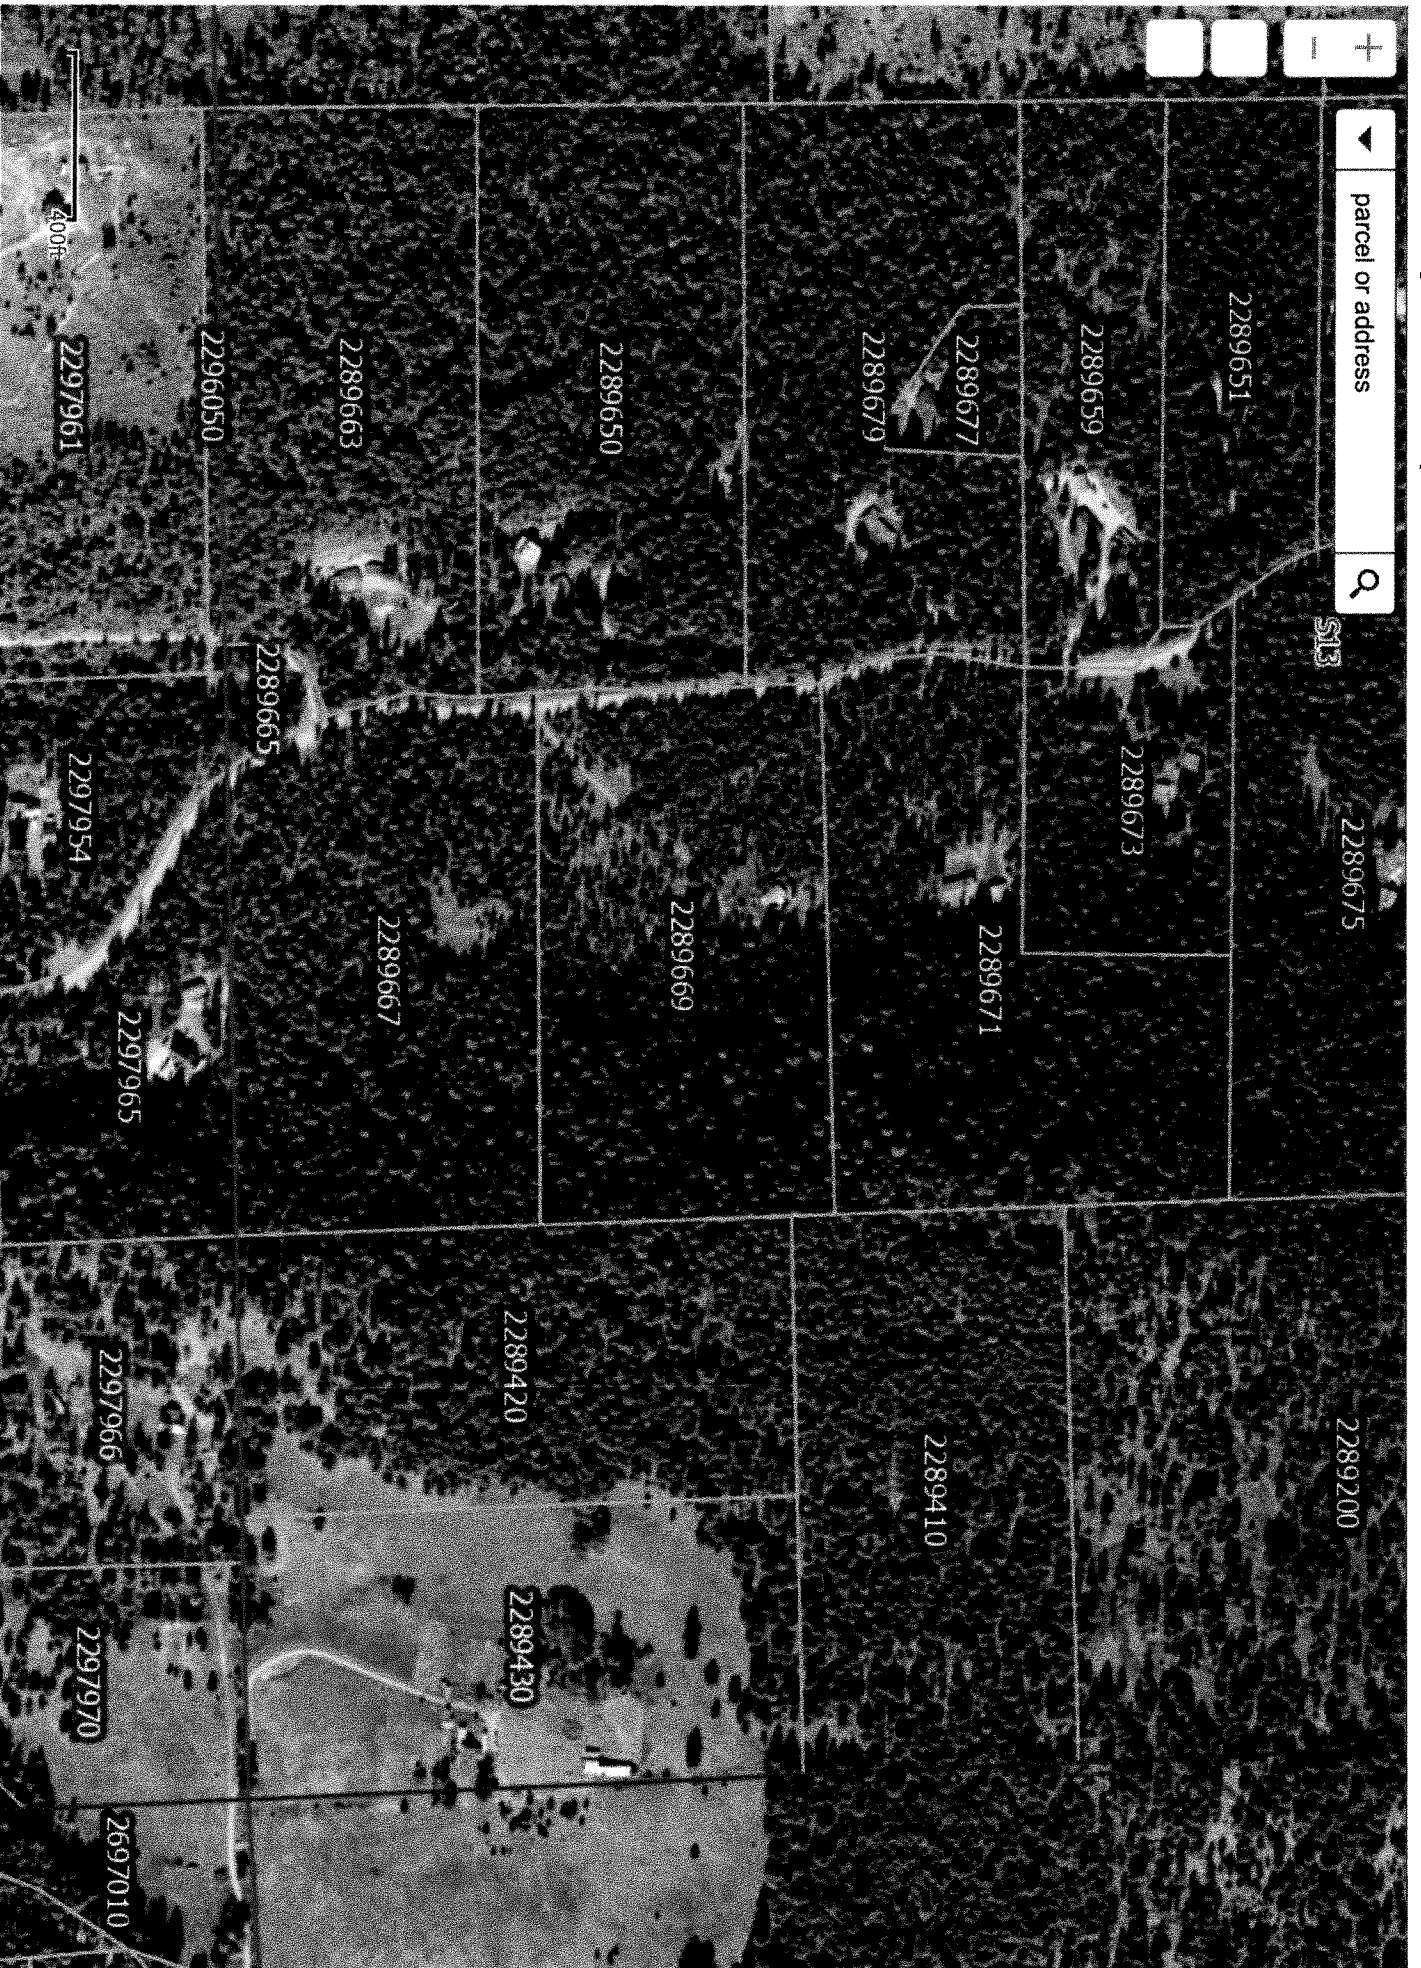

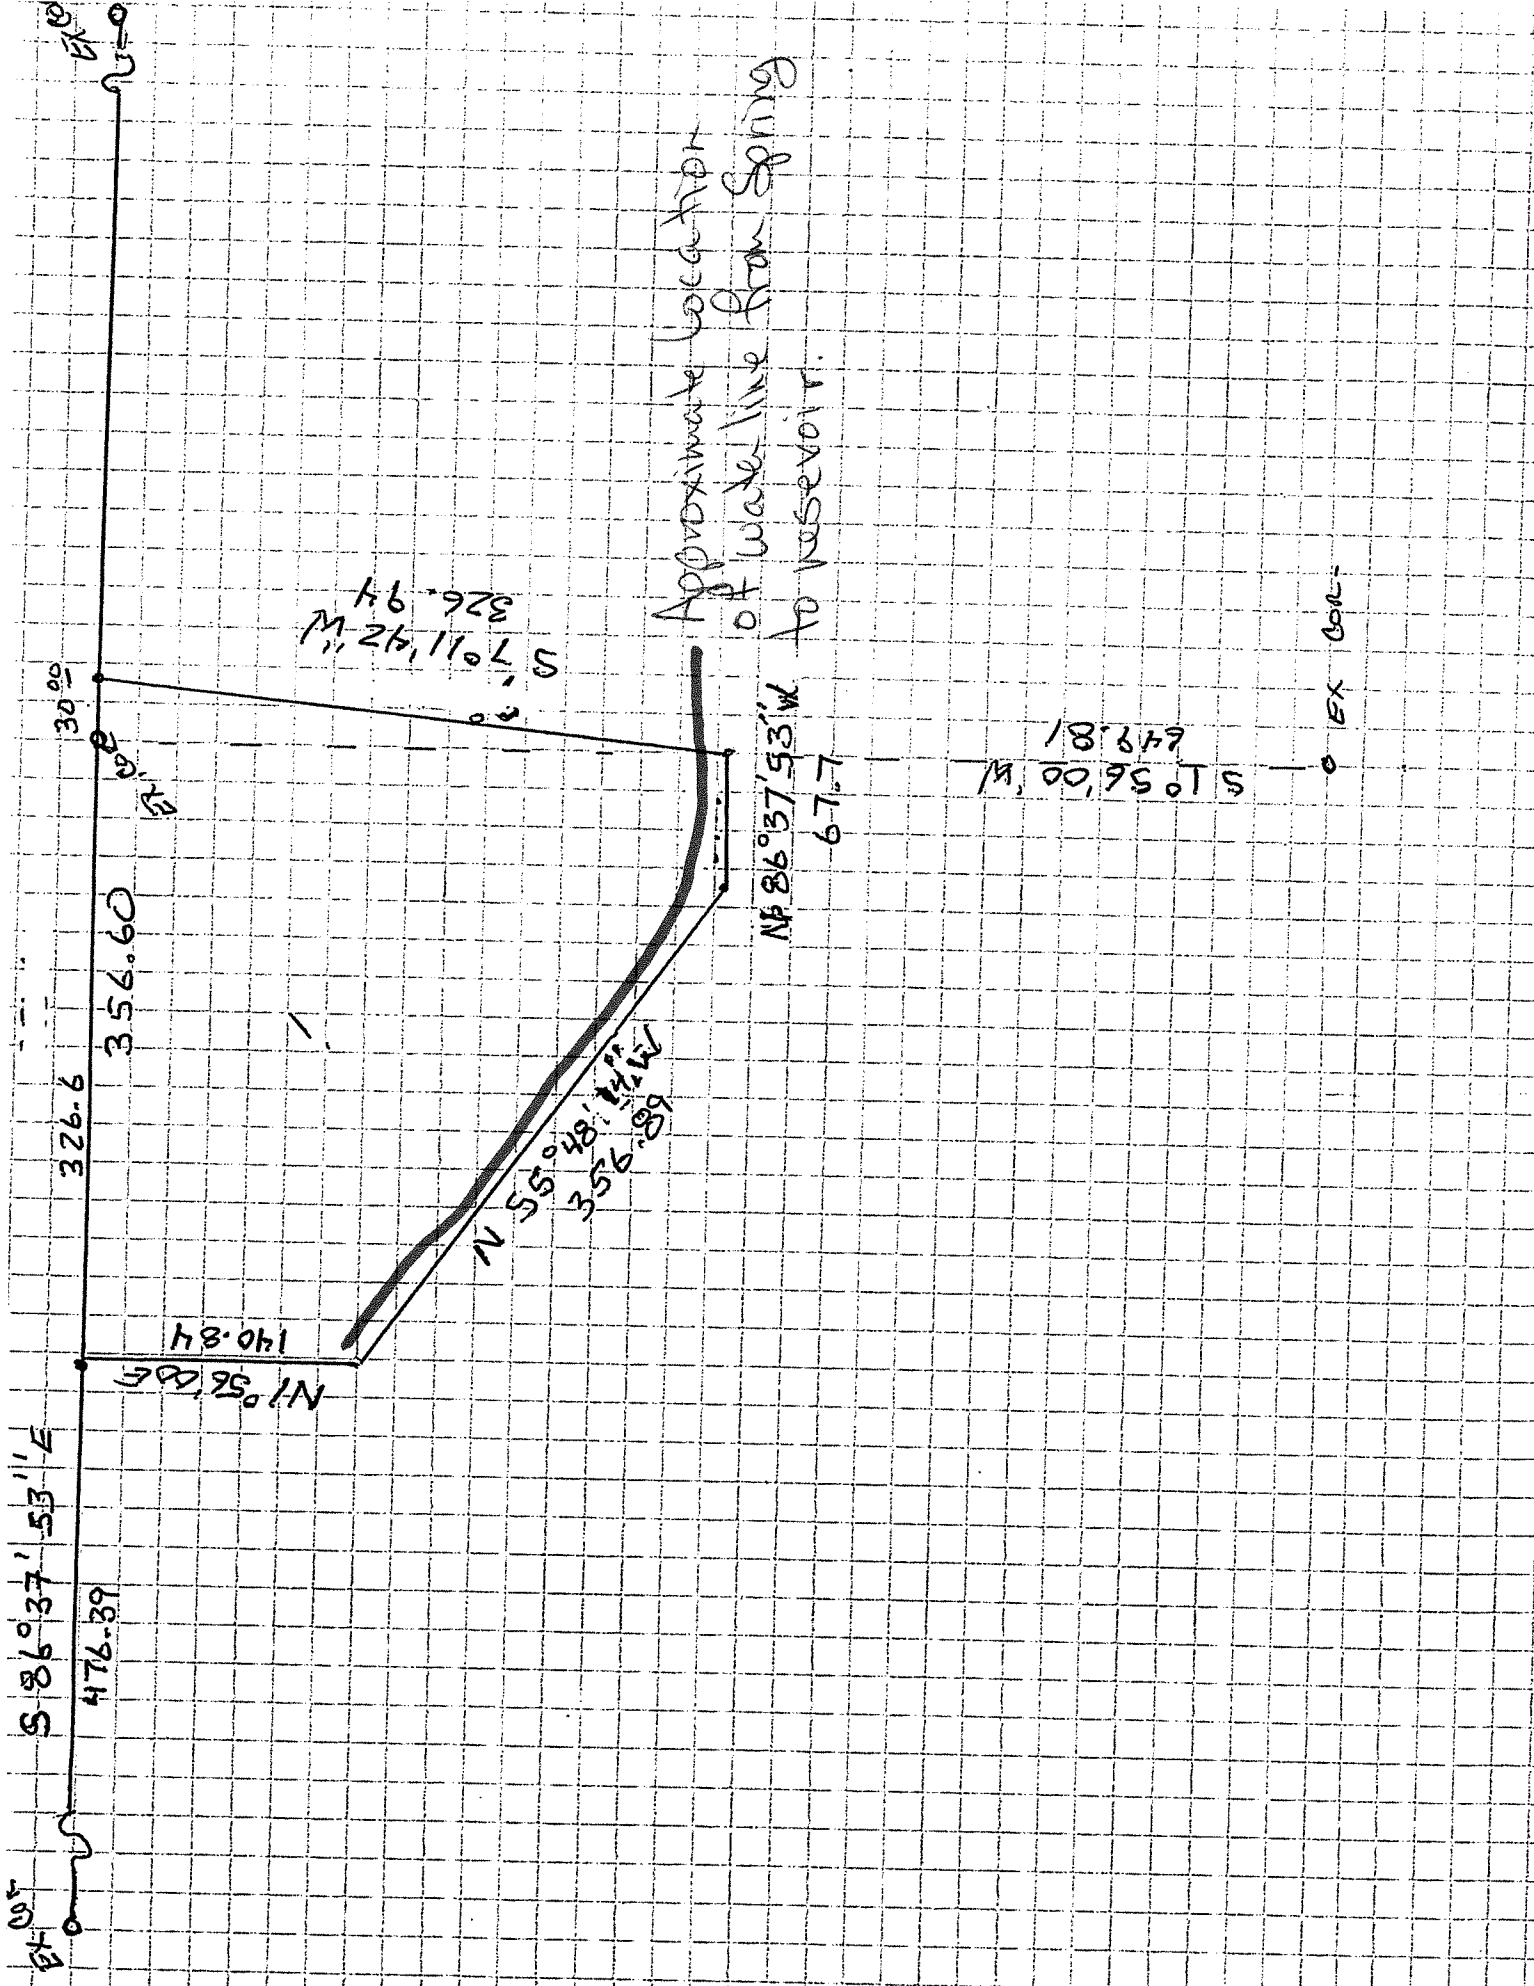

Approximate location of water line from Spring to reservoir.