


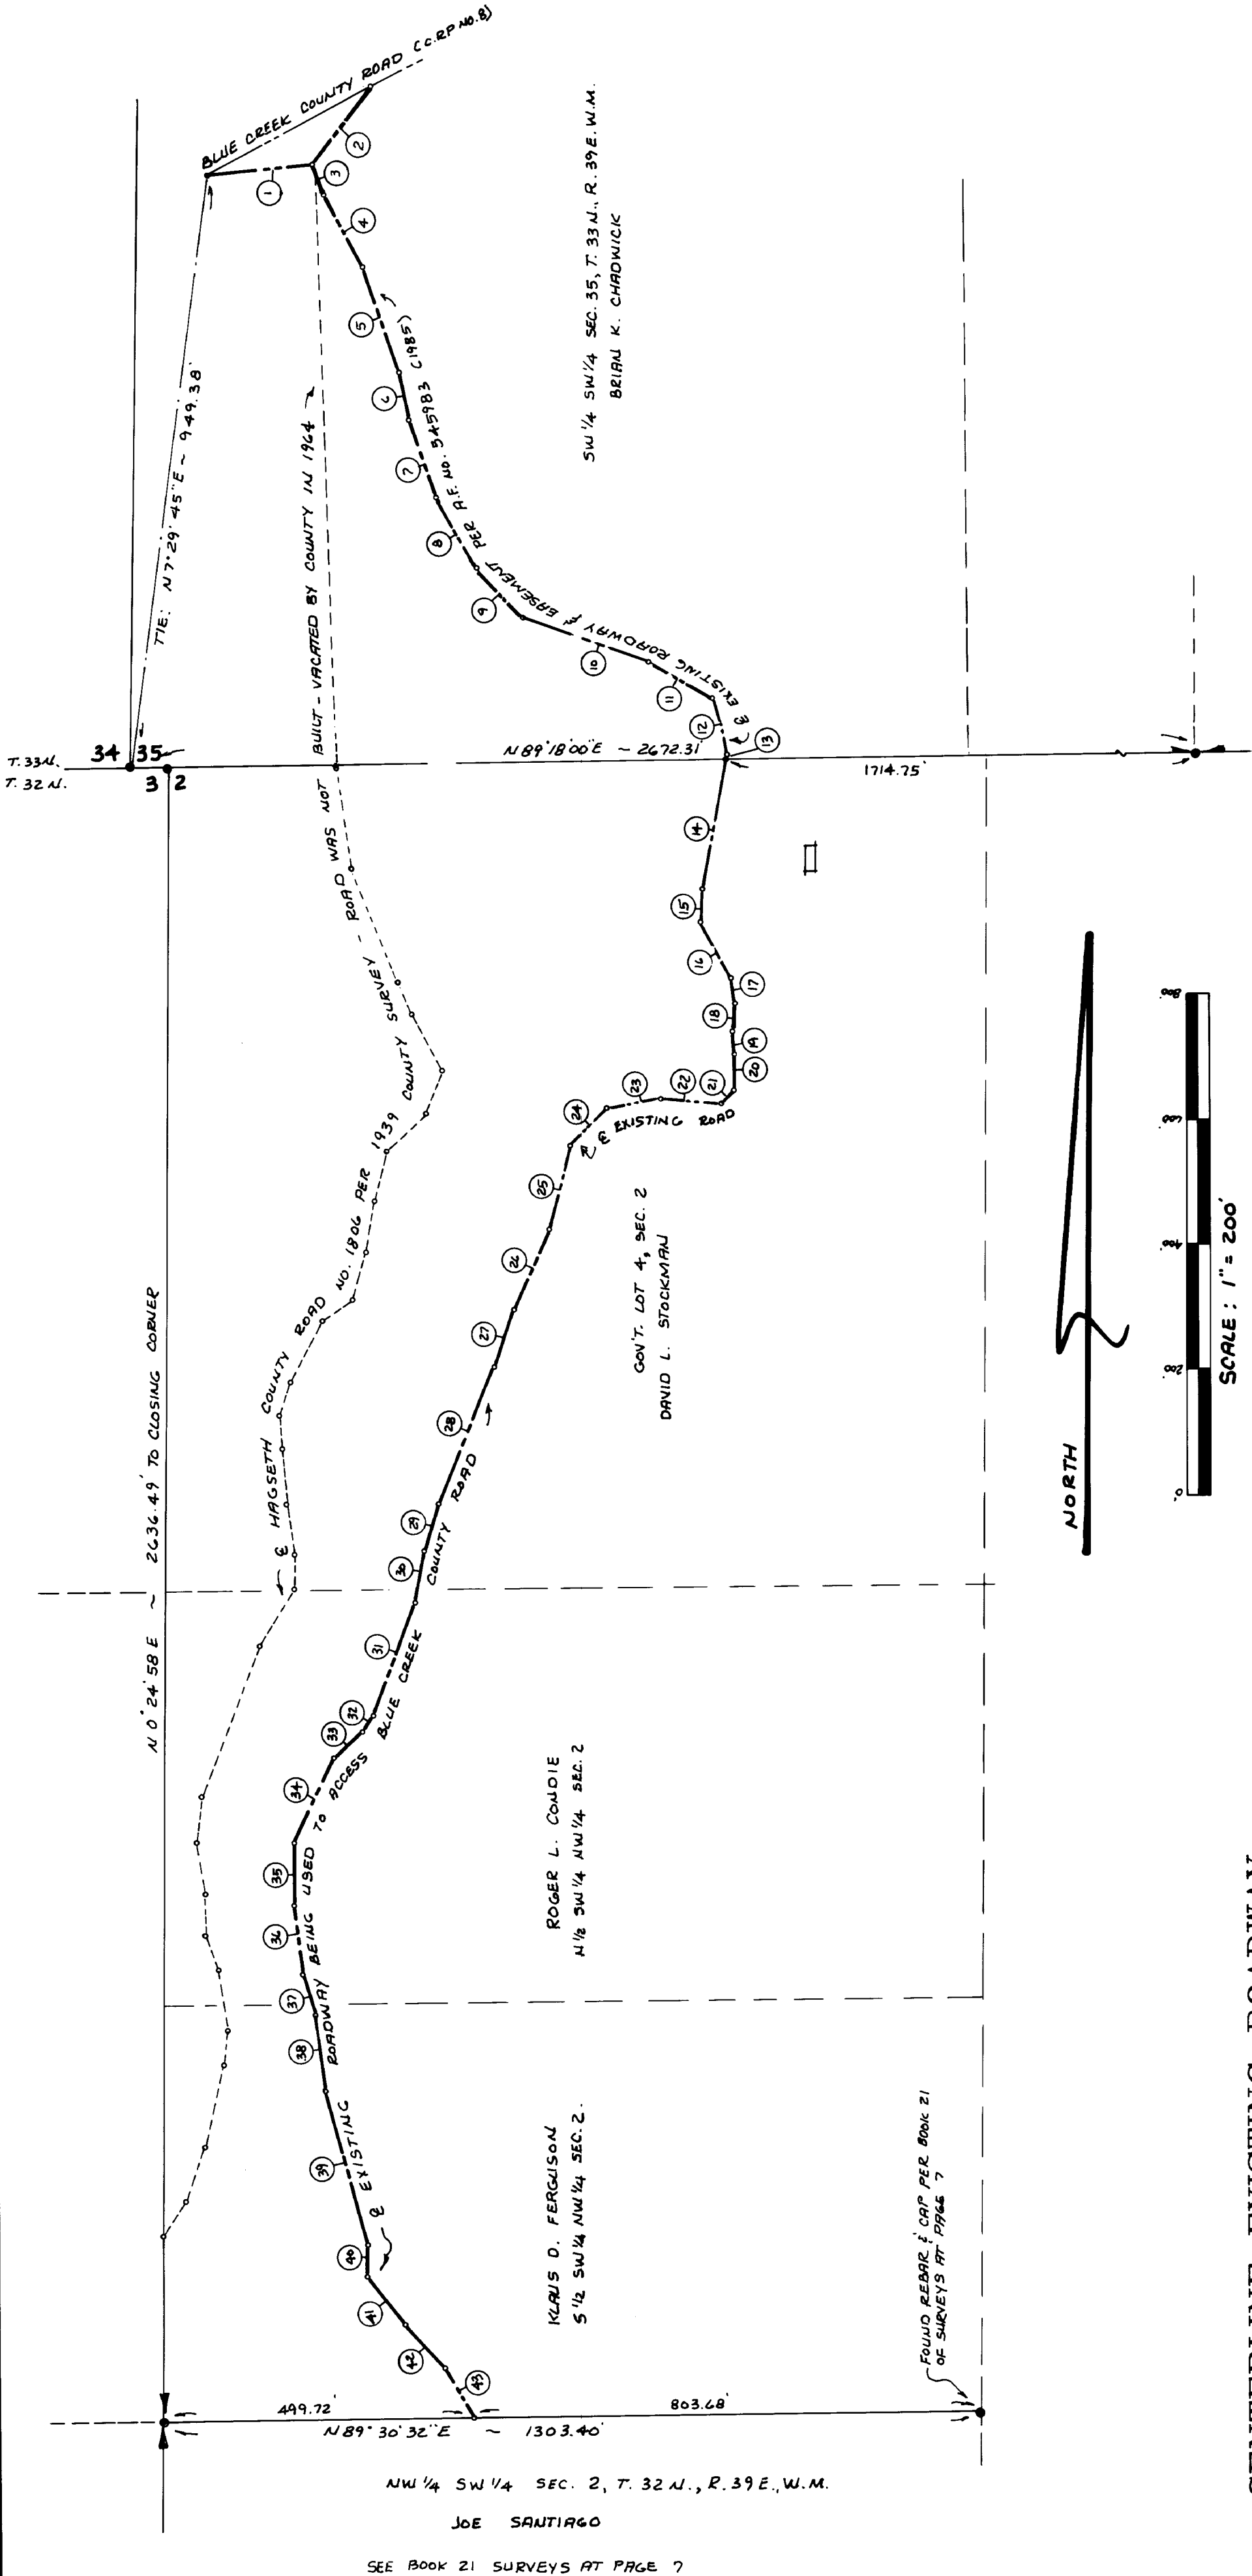

CENTERLINE EXISTING ROADWAY

1. N 85° 33' 45" E 173.82 FT.
2. S 37° 11' 12" W 155.45 FT.
3. S 20° 00' 43" E 49.58 FT.
4. S 29° 24' 00" E 131.40 FT.
5. S 17° 41' 59" E 178.62 FT.
6. S 14° 18' 10" E 80.04 FT.
7. S 18° 52' 47" E 129.27 FT.
8. S 28° 09' 53" E 131.22 FT.
9. S 44° 05' 34" E 104.13 FT.
10. S 71° 01' 29" E 211.05 FT.
11. S 60° 49' 44" E 114.59 FT.
12. S 17° 18' 04" E 95.35 FT.
13. S 11° 11' 13" W 7.15 FT.
14. S 0° 08' 17" W 51.64 FT.
15. S 27° 58' 33" E 97.36 FT.
16. S 8° 17' 16" E 42.52 FT.
17. S 4° 08' 18" W 45.61 FT.
18. S 3° 01' 11" E 35.63 FT.
19. S 0° 59' 07" E 58.47 FT.
20. S 45° 40' 04" W 29.70 FT.
21. S 85° 10' 08" W 99.44 FT.
23. S 80° 19' 08" W 82.55 FT.
24. S 43° 20' 59" W 86.64 FT.
25. S 14° 03' 53" W 136.68 FT.
26. S 28° 44' 02" W 138.40 FT.
27. S 18° 34' 30" W 96.96 FT.
28. S 22° 20' 35" W 235.95 FT.
29. S 15° 45' 59" W 75.99 FT.
30. S 11° 33' 20" W 192.15 FT.
31. S 20° 24' 49" W 30.66 FT.
32. S 34° 13' 53" W 62.64 FT.
33. S 47° 30' 40" W 147.97 FT.
34. S 25° 06' 56" W 97.98 FT.
35. S 0° 02' 41" W 114.24 FT.
36. S 8° 34' 18" E 65.56 FT.
37. S 15° 45' 27" E 122.49 FT.
38. S 7° 11' 51" E 254.35 FT.
39. S 14° 57' 55" E 48.55 FT.
40. S 1° 58' 44" E 98.11 FT.
41. S 37° 20' 56" E 96.91 FT.
42. S 44° 07' 01" E 96.91 FT.
43. S 28° 27' 58" E 91.45 FT.

SURVEYOR'S CERTIFICATE

THIS MAP CORRECTLY REPRESENTS A SURVEY MADE BY ME OR UNDER MY DIRECTION IN CONFORMANCE WITH THE REQUIREMENTS OF THE SURVEY RECORDING ACT AT THE REQUEST OF

JOE SANTIAGO IN SEPT 2000-MAY 2001.

THOMAS E. TODD, L.S. 19648
455 SOUTH OAK STREET
COLVILLE, WASHINGTON 99114
(509) 684-8861

2001 0005263

AUDITOR'S CERTIFICATE

FILED FOR RECORD THIS 5TH DAY OF June 2001, AT 11:53 AM, IN BOOK 21 OF SURVEYS AT PAGE 84, AT THE REQUEST OF THOMAS E. TODD.

Tim Gray
COUNTY AUDITOR

F. Clinton
DEPUTY AUDITOR

FEE 25.00
DNR 26.00
CS 2.00
SAF 1.00

Val 259 1047

RECORD OF SURVEY

OF AN EXISTING ROADWAY IN THE SW 1/4 OF THE SW 1/4 OF SECTION 35, T. 33 N., R. 39 E., W.M., AND IN THE W 1/2 OF THE NW 1/4 OF FRACTIONAL SECTION 2, T. 32 N., R. 39 E., W.M., ALL IN STEVENS COUNTY, WASHINGTON.