

File Original and First Copy with  
Department of Ecology  
Second Copy — Owner's Copy  
Third Copy — Driller's Copy

# 507378 WATER WELL REPORT

STATE OF WASHINGTON

Water Right Permit No.

Start Card No. 10060453UNIQUE WELL I.D. # AGG 990OWNER: Name Jim Knof

Address

22529 Hwy 25 South

(2) LOCATION OF WELL: County


(2a) STREET ADDRESS OF WELL (or nearest address)

(3) PROPOSED USE: ☒ Domestic ☐ Industrial ☐ Municipal ☐  
☐ Irrigation ☐ Test Well ☐ Other ☐  
☐ DeWater

(4) TYPE OF WORK: Owner's number of well (if more than one) 2

Abandoned ☐ New well ☐ Method: Dug ☐ Bored ☐  
Deepened ☐ Cable ☐ Driven ☐  
Reconditioned ☐ Rotary ☒ Jetted ☐

(5) DIMENSIONS: Diameter of well 6 inches.  
Drilled \_\_\_\_\_ feet. Depth of completed well \_\_\_\_\_ ft.

(6) CONSTRUCTION DETAILS:

Casing installed: 6 Diam. from + ft. to \_\_\_\_\_ ft.  
Welded ☒ Diam. from \_\_\_\_\_ ft. to \_\_\_\_\_ ft.  
Liner installed ☐ Threaded ☐ Diam. from \_\_\_\_\_ ft. to \_\_\_\_\_ ft.

Perforations: Yes ☐ No ☒

Type of perforator used \_\_\_\_\_

SIZE of perforations \_\_\_\_\_ in. by \_\_\_\_\_ in.

\_\_\_\_\_ perforations from \_\_\_\_\_ ft. to \_\_\_\_\_ ft.  
\_\_\_\_\_ perforations from \_\_\_\_\_ ft. to \_\_\_\_\_ ft.  
\_\_\_\_\_ perforations from \_\_\_\_\_ ft. to \_\_\_\_\_ ft.

Screens: Yes ☐ No ☒

Manufacturer's Name \_\_\_\_\_

Type \_\_\_\_\_ Model No. \_\_\_\_\_

Diam. \_\_\_\_\_ Slot size \_\_\_\_\_ from \_\_\_\_\_ ft. to \_\_\_\_\_ ft.

Diam. \_\_\_\_\_ Slot size \_\_\_\_\_ from \_\_\_\_\_ ft. to \_\_\_\_\_ ft.

Gravel packed: Yes ☐ No ☒ Size of gravel \_\_\_\_\_

Gravel placed from \_\_\_\_\_ ft. to \_\_\_\_\_ ft.

Surface seal: Yes ☐ No ☐ To what depth? 20 ft.Material used in seal BeniteDid any strata contain unusable water? Yes ☐ No ☒

Type of water? \_\_\_\_\_ Depth of strata \_\_\_\_\_

Method of sealing strata off \_\_\_\_\_

(7) PUMP: Manufacturer's Name \_\_\_\_\_

Type: \_\_\_\_\_ H.P. \_\_\_\_\_

(8) WATER LEVELS: Land-surface elevation above mean sea level \_\_\_\_\_ ft.

Static level 205 ft. below top of well Date 3/1

Artesian pressure \_\_\_\_\_ lbs. per square inch Date \_\_\_\_\_

Artesian water is controlled by \_\_\_\_\_ (Cap, valve, etc.)

(9) WELL TESTS: Drawdown is amount water level is lowered below static level

Was a pump test made? Yes ☐ No ☐ If yes, by whom? \_\_\_\_\_

Yield: \_\_\_\_\_ gal./min. with \_\_\_\_\_ ft. drawdown after \_\_\_\_\_ hrs.

" " " "

" " " "

Recovery data (time taken as zero when pump turned off) (water level measured from well top to water level)

Time Water Level Time Water Level Time Water Level

Date of test \_\_\_\_\_

Bailer test \_\_\_\_\_ gal./min. with \_\_\_\_\_ ft. drawdown after \_\_\_\_\_ hrs.

Airstest 50 gal./min. with stem set at 300 ft. for 2 hrs.

Artesian flow \_\_\_\_\_ g.p.m. Date \_\_\_\_\_

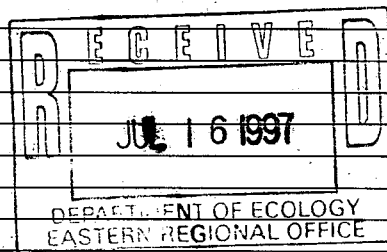
Temperature of water \_\_\_\_\_ Was a chemical analysis made? Yes ☐ No ☐

(10) WELL LOG or ABANDONMENT PROCEDURE DESCRIPTION

Formation: Describe by color, character, size of material and structure, and show thickness of aquifers and the kind and nature of the material in each stratum penetrated, with at least one entry for each change of information.

MATERIAL	FROM	TO
<u>Gravelly Sand</u>	<u>0</u>	<u>40</u>
<u>Gravel</u>	<u>40</u>	<u>45</u>
<u>Sand</u>	<u>45</u>	<u>90</u>
<u>Sand &amp; Gravel</u>	<u>90</u>	<u>120</u>
<u>Sand</u>	<u>120</u>	<u>160</u>
<u>Sand &amp; Gravel "Damp"</u>	<u>160</u>	<u>220</u>
<u>Gravel "Wet"</u>	<u>220</u>	<u>260</u>
<u>5 gon</u>	<u>260</u>	<u>285</u>
<u>Big Gravel 30 gon</u>	<u>285</u>	<u>300</u>
<u>gravel + Sand</u>	<u>300</u>	<u>310</u>
<u>Sand</u>	<u>310</u>	<u>325</u>
<u>black Clay + sand</u>	<u>325</u>	<u>340</u>

Pulled casing back  
+ completed @ 300'  
w/o screen

Work Started 2/11 19. Completed 2/26 1997

## WELL CONSTRUCTOR CERTIFICATION:

I constructed and/or accept responsibility for construction of this well, and its compliance with all Washington well construction standards. Materials used and the information reported above are true to my best knowledge and belief.

NAME K.C. Bave Drilling  
(PERSON, FIRM, OR CORPORATION) (TYPE OR PRINT)Address Spokane WA(Signed) Seal Jones License No. 2151  

(USE ADDITIONAL SHEETS IF NECESSARY)

Ecology is an Equal Opportunity and Affirmative Action employer. For special accommodation needs, contact the Water Resources Program at (206) 407-6600. The TDD number is (206) 407-6006.