


Forest Practices Activity Map - Application

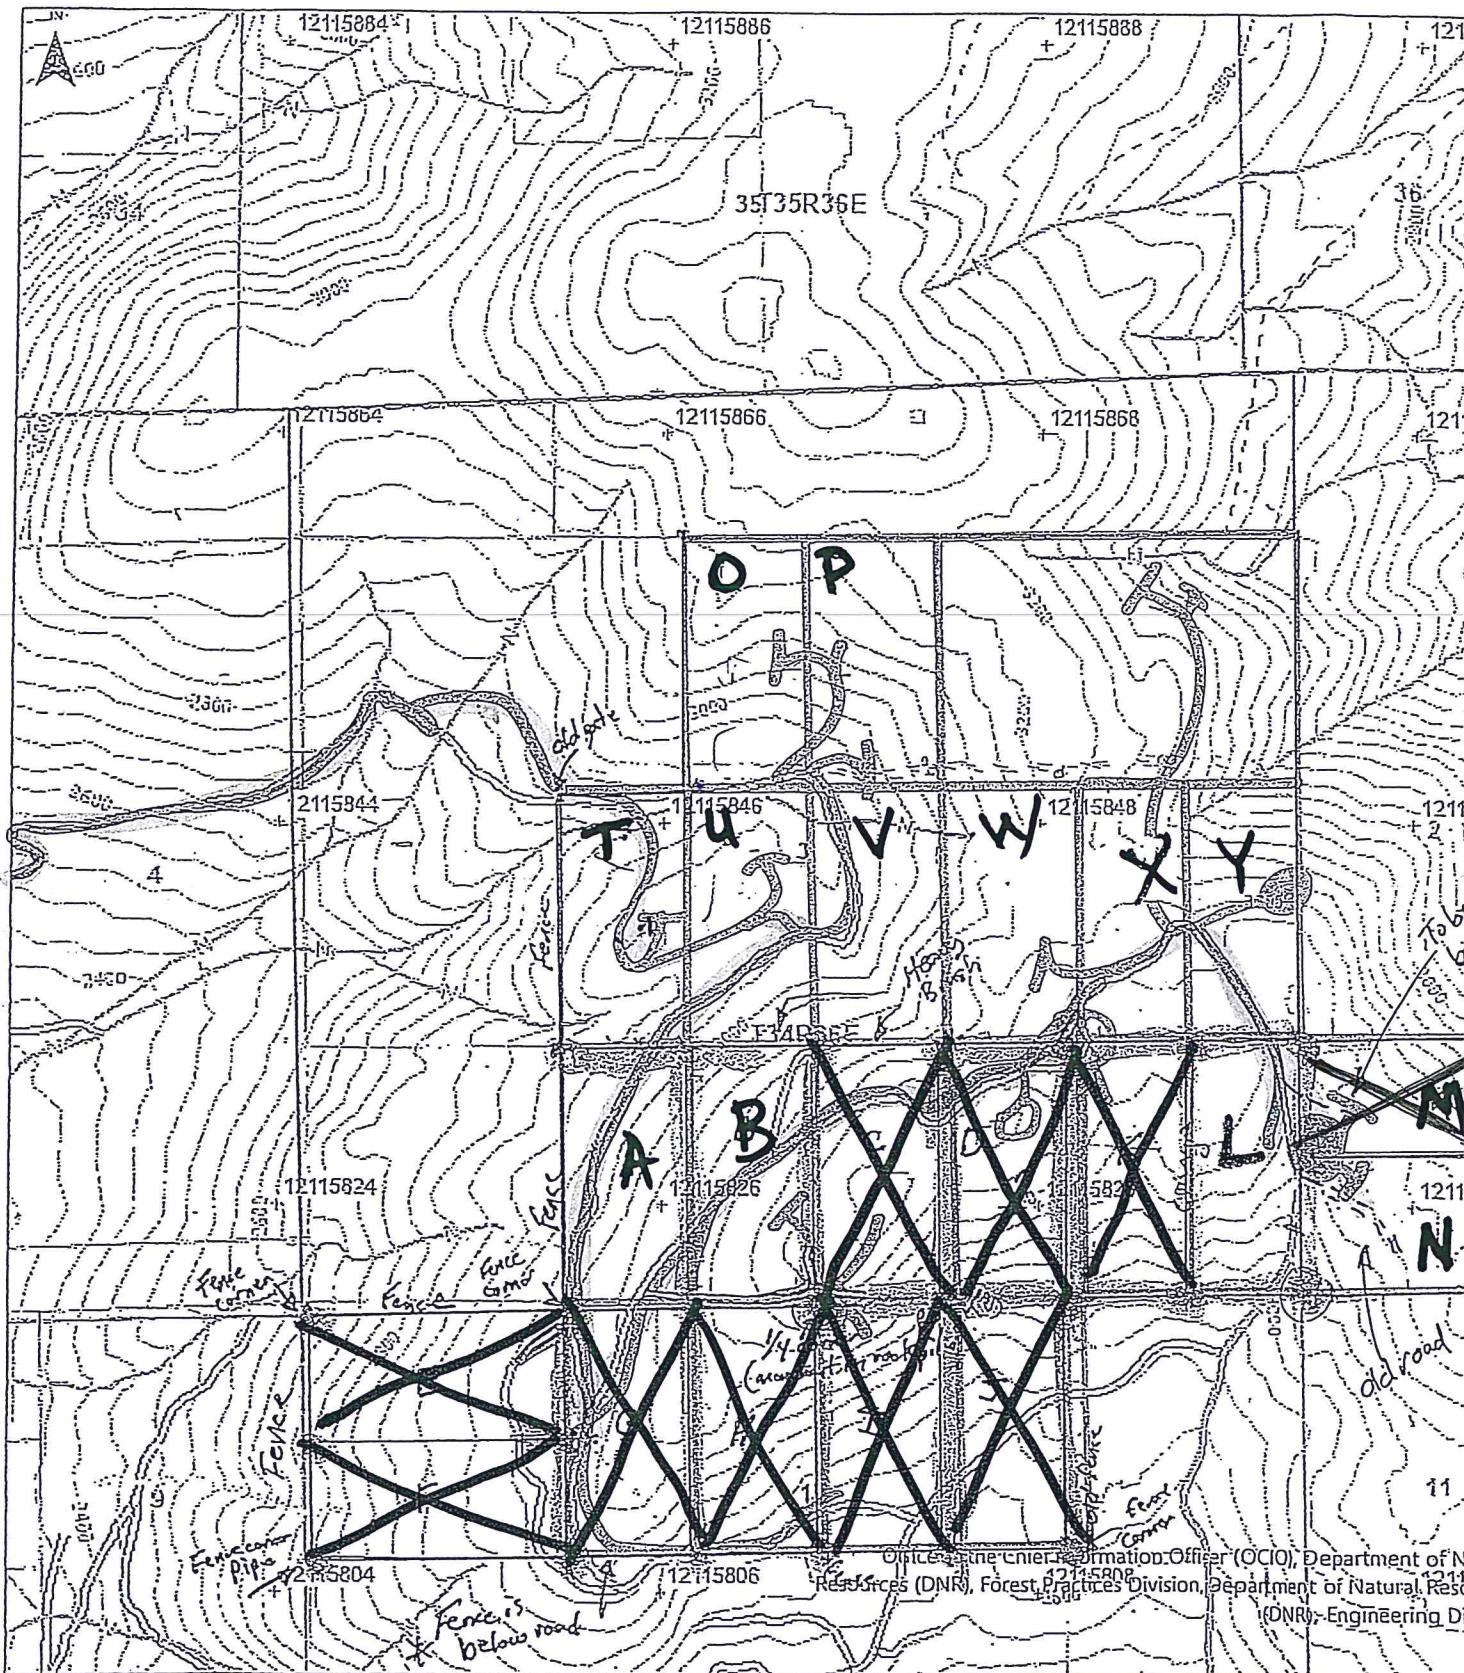

Map Symbols

--- Harvest Boundary	⊙ Landing
- - - Road Construction	▽ Waste Area
~ Stream	⊕ Clumped WRTS/GRTS
⊗ RMZ / WMZ Buffers	⊕ Existing Structure
⊗ Rock Pit	

Additional Information

* Approx. corners and lines
 Flagged lines -
 Approx. corners
 wsb
 6/24/24 - 8/18/24

Legal Description

S11 T34.0N R36.0E, S09 T34.0N
 S34 T35.0N R36.0E, S35 T35.0N
 R36.0E, S36 T35.0N R36.0E, S0
 R36.0E, S02 T34.0N R36.0E, S0
 R36.0E, S10 T34.0N R36.0E



WASHINGTON STATE DEPARTMENT OF
NATURAL RESOURCES

Extreme care was used during the compilation of this map to ensure its accuracy. However, due to changes in data and the need to rely on outside information, the Department of Natural Resources cannot accept responsibility for errors or omissions, and therefore, there are no warranties that accompany this material.

Approximate Scale : 1:12,000
 0 500 1,000

Date: 6/24/2024 Time: 1:24 PM

[illegible]

4