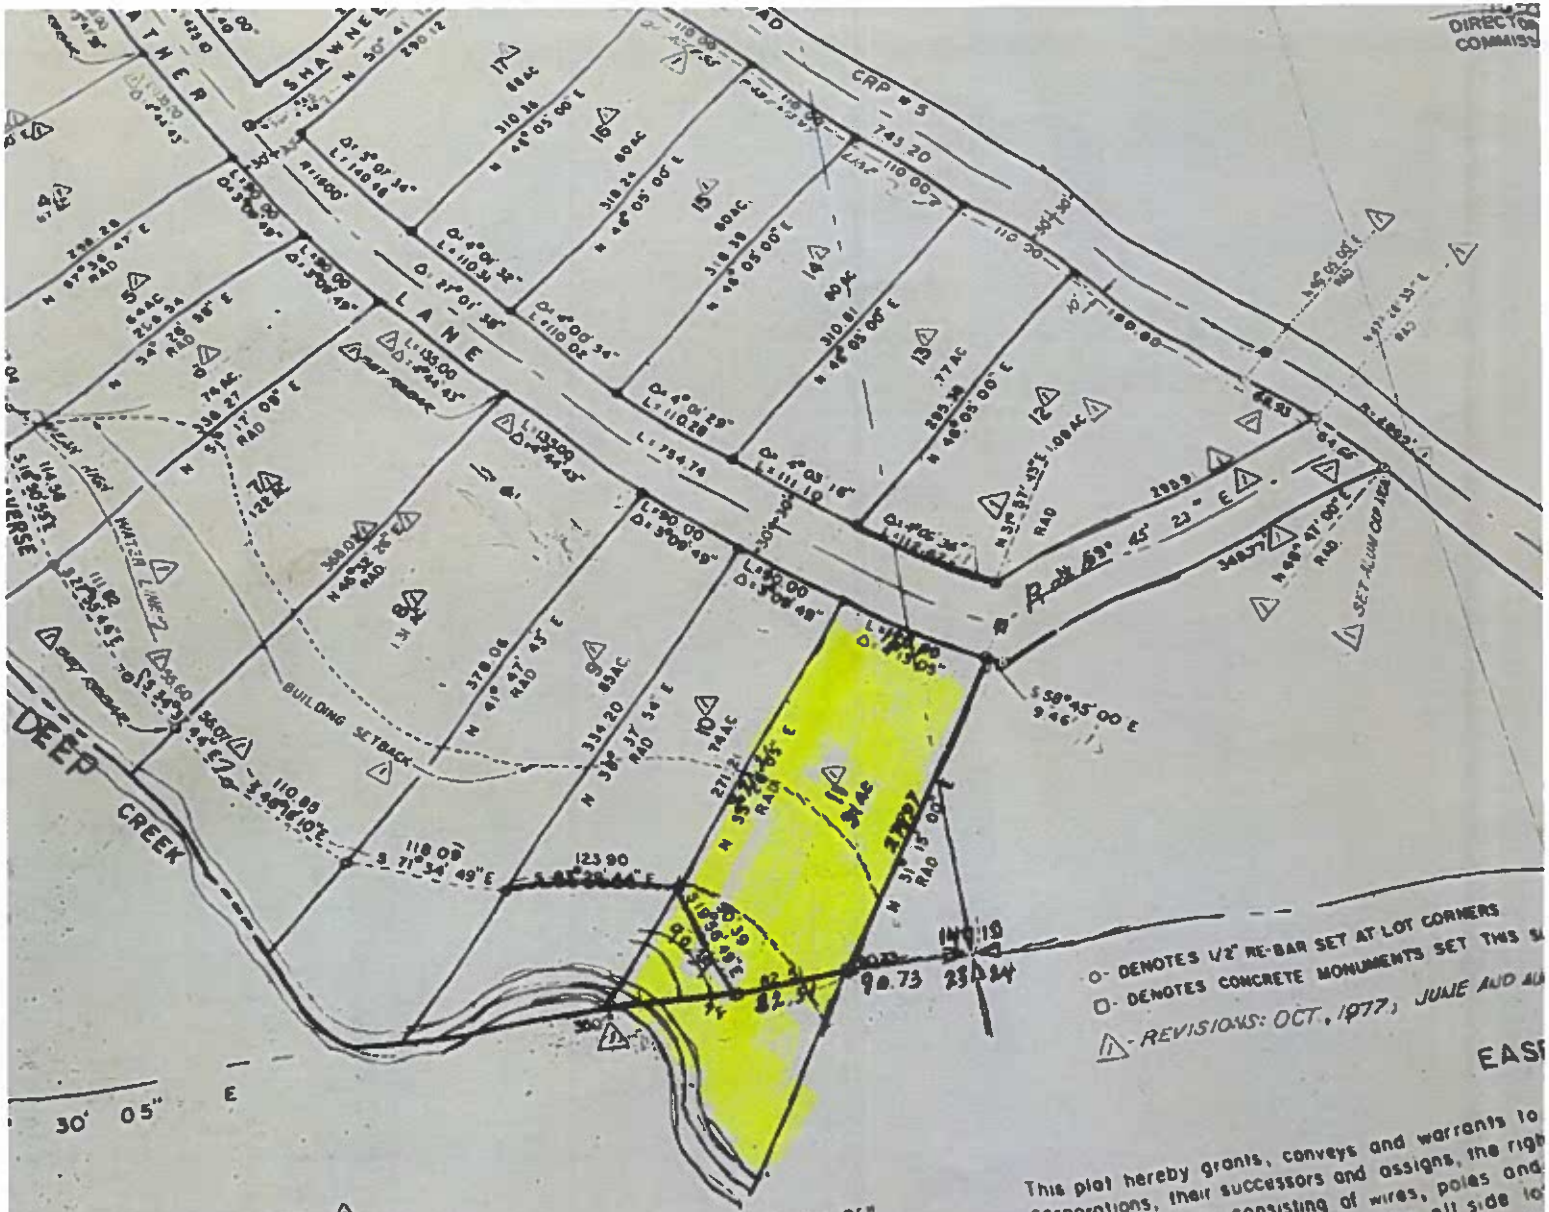

DESCRIPTION

14, TOWNSHIP 39 NORTH, RANGE 40 EAST, W.M.; thence SOUTH 88° 30' 05" a distance of 90.73 feet to the TRUE POINT OF BEGINNING; thence NORTH thence SOUTH 58° 45' 00" EAST a distance of 9.46 feet; thence NORTH a point on the arc of a curve having a radius of 2835.00 feet, said of a 60.00 foot wide county road; thence NORTHWESTERLY along the arc 30'". a distance of 133.59 feet; thence NORTH 43° 55' 00" WEST along the of 1172.11 feet to the NORTH Line of the SOUTHEAST ¼ of the SOUTHEAST ¼ WEST along said NORTH Line a distance of 420 feet, more or less, to the said centerline to a point on the SOUTH Line of Said SECTION BEGINNING; thence NORTH 88° 30' 05" EAST along

This plat hereby grants, conveys and warrants to corporations, their successors and assigns, the righ distribution lines consisting of wires, poles and feet of lots adjoining and abutting all side lo together with the right to inspect said lines

LAND SURVEY

I, Donald K. Ellersick, registered as a certify that the amendments den under my supervision in October and June, 1979.