

Auditor File #: 2006 0007480

Recorded at the request of:

RANDAL G. SIEGER

on 06/26/2006 at 14:35

Total of 1 page(s) Paid: \$ 98.00  
STEVENS COUNTY, WASHINGTON  
TIM GRAY, AUDITOR

**SURVEY** KKUHLE

**OWNERS** DAVID C. DIXON & ELLEN D. DIXON

**TO SURVEY** RANDAL G. SIEGER  
**FILED BY** RANDAL G. SIEGER

**SURVEYOR** RANDAL G. SIEGER

**SURVEY BOOK** 26 **PAGE** 65

**FEE\$** 25.70 **DNR\$** 46.00

**CS \$** 5.00 **SAF\$** 2.00

**LOW INCOME HOUSING \$** 9.50 **HOMELESS** 9.80


**LEGAL DESCRIPTION: SECTION** 17 **TWP** 35 **RGE** 41

**LEGAL DESCRIPTION: SECTION**                    **TWP**                    **RGE**                   

**LEGAL DESCRIPTION: SECTION**                    **TWP**                    **RGE**                   

**LEGAL DESCRIPTION: SECTION**                    **TWP**                    **RGE**                   

**ADDITIONAL INFORMATION:** PORTION NW1/4

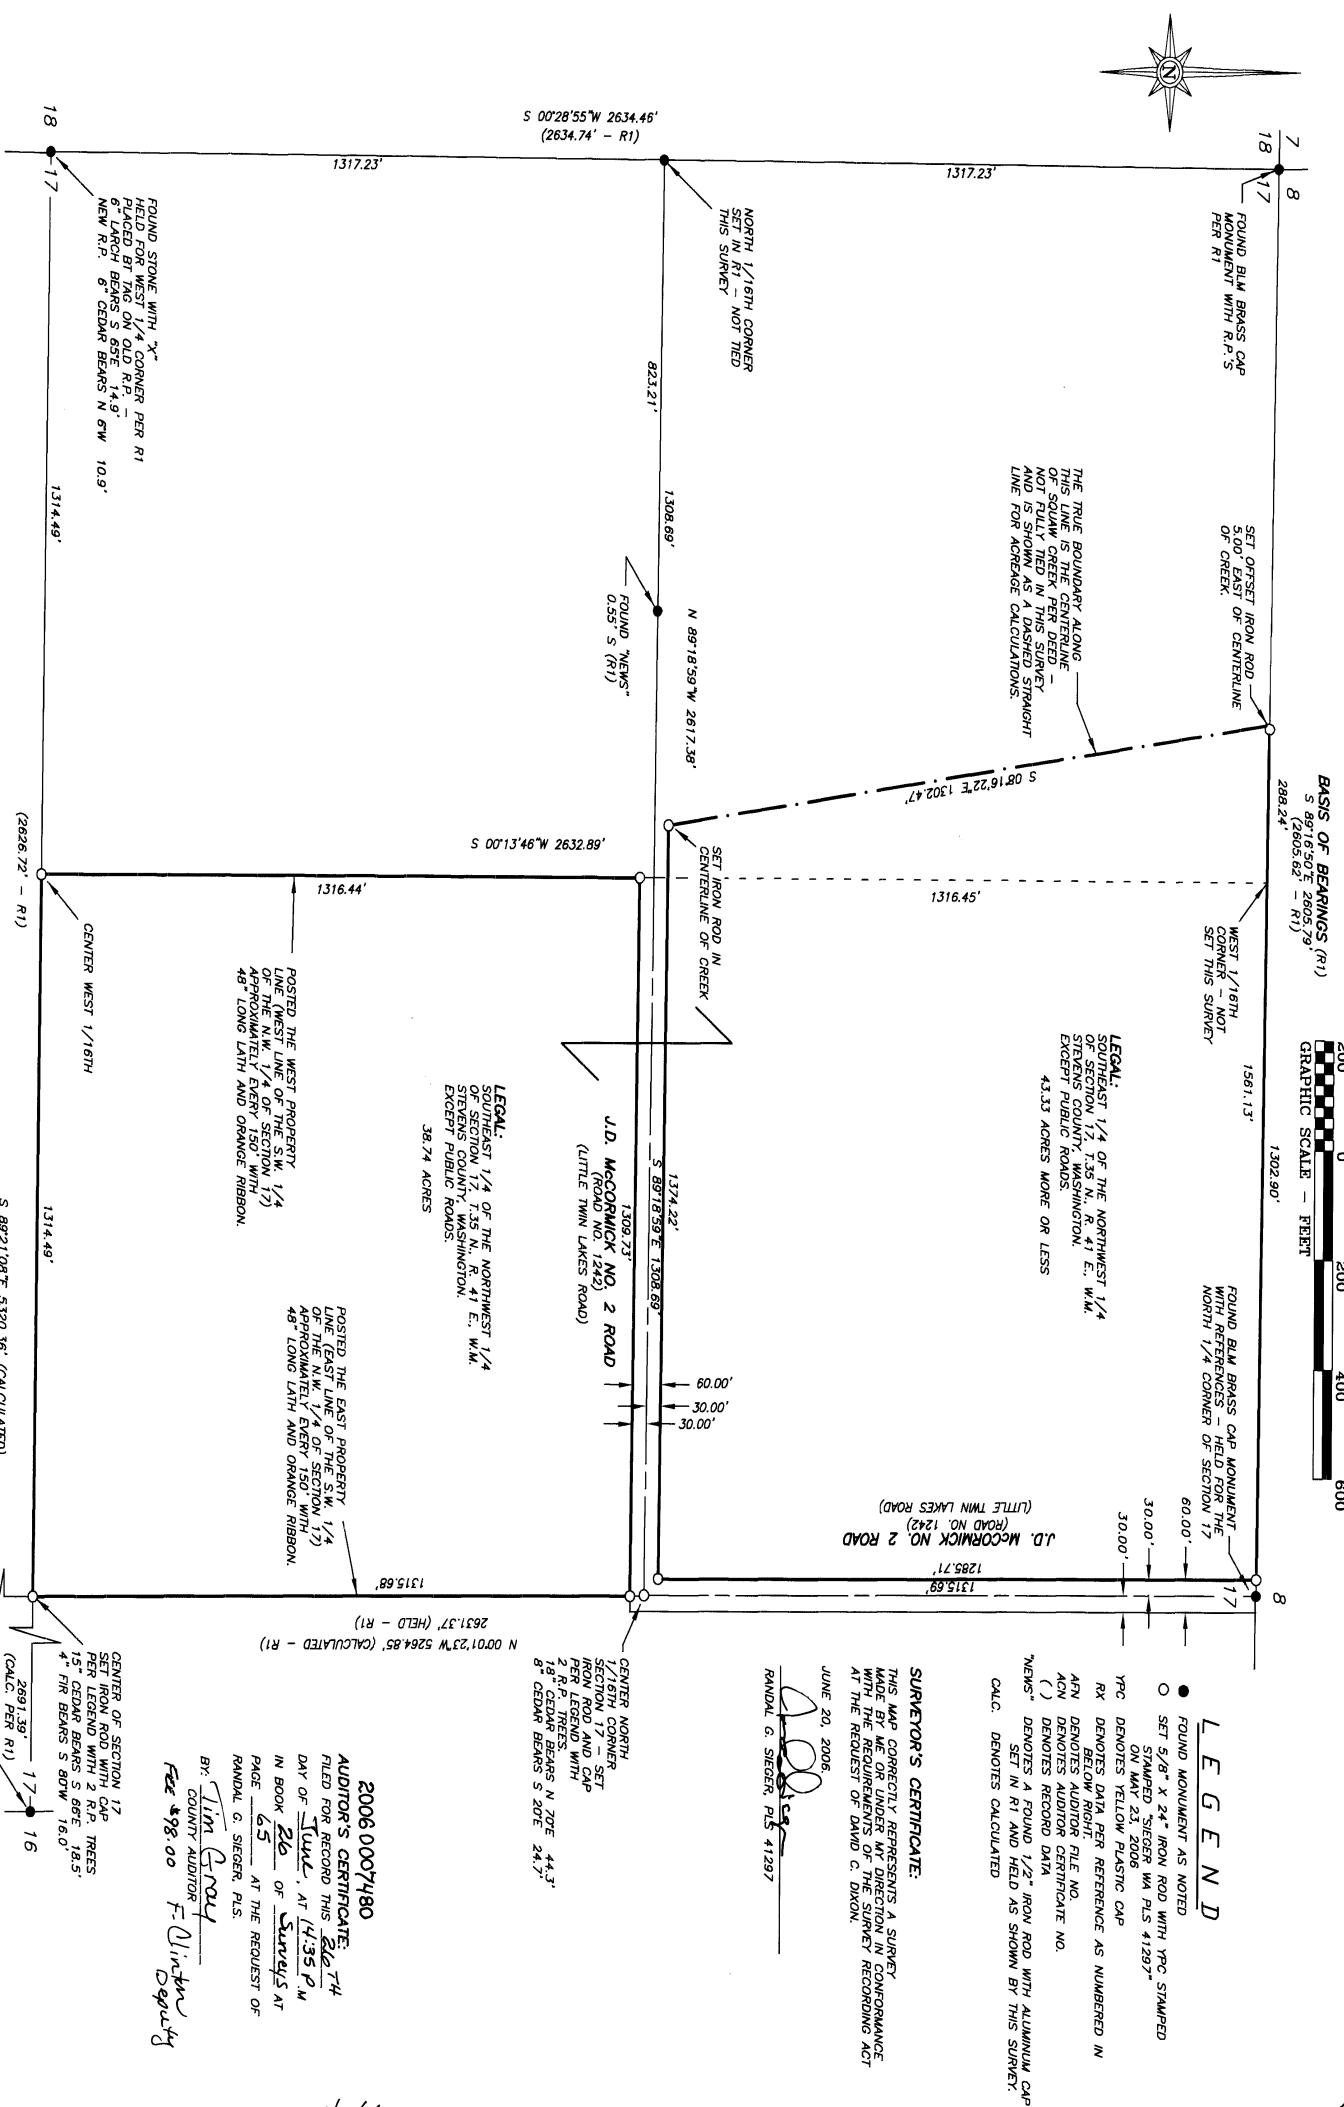

*RECORD OF SURVEY*

A TRACT OF LAND LOCATED IN THE NORTHWEST  
ONE QUARTER OF SECTION 17, TOWNSHIP 35 NORTH  
RANGE 41 EAST OF THE WILLAMETTE MERIDIAN,  
STEVENS COUNTY, STATE OF WASHINGTON.



PREPARED FOR:  
DAVID C.  
&  
ELLEN D.  
DIXON

DATE: JUNE 20, 2006  
SCALE: 1" = 200'  
REVIEWED BY:  
DRAWN BY:  
PROJECT NO.: R.G.S. 06-008  
DWG.: 06-008ROS

**RANDAL SIEGER**  
**OREGON / WASHINGTON**

**SHEET**  
**1**

**OF**  
**1**